

WATER SERVICE RECORD

1485
Service No. 138

Name Philip Garfield

Address 16 Balfour Street

Location Lexington, Mass.

3918


Repair - ~~Renovate~~ - New Service *Com 17 24/51*

Date	Material	Amount	Total	Date	Amount
7-19-51	Labor	2 76	2 76	6-27-51	Deposited 45 10
	10% Overhead		28	10-9-51	Paid 1 45
	70'-3/4" Copper Tubing @.326	22 82			76 83
	1-3/4" Cx 1/2" L.W.H. S&W	4 00			No Charge
	1-3/4" Cx 3/4" C Union (3 pts)	1 72		7-19-51	Labor 5 30
	2 Hrs. Littlefield Shovel	14 00		21'-3/4" Copper Tubing @.326	6 84
	1 Hr. Trucking	75		1-3/4" C Corp-Cock	4 33
		46 33		1-3/4" Cx 3/4" C Curb-Cock	4 67
				1 Box & Rod	4 68
				1-1/8" Offset Tail Piece	50
				1-1/8" Straight Tail Piece	50
				2 Hrs. Littlefield Shovel	14 00
				1 Hr. Trucking	75
					42 57
					<i>6-27-51 9-24-51</i>

DATE _____

TOWN OF LEXINGTON — BOARD OF PUBLIC WORKS
WATER DIVISION

Sketch of Service Here

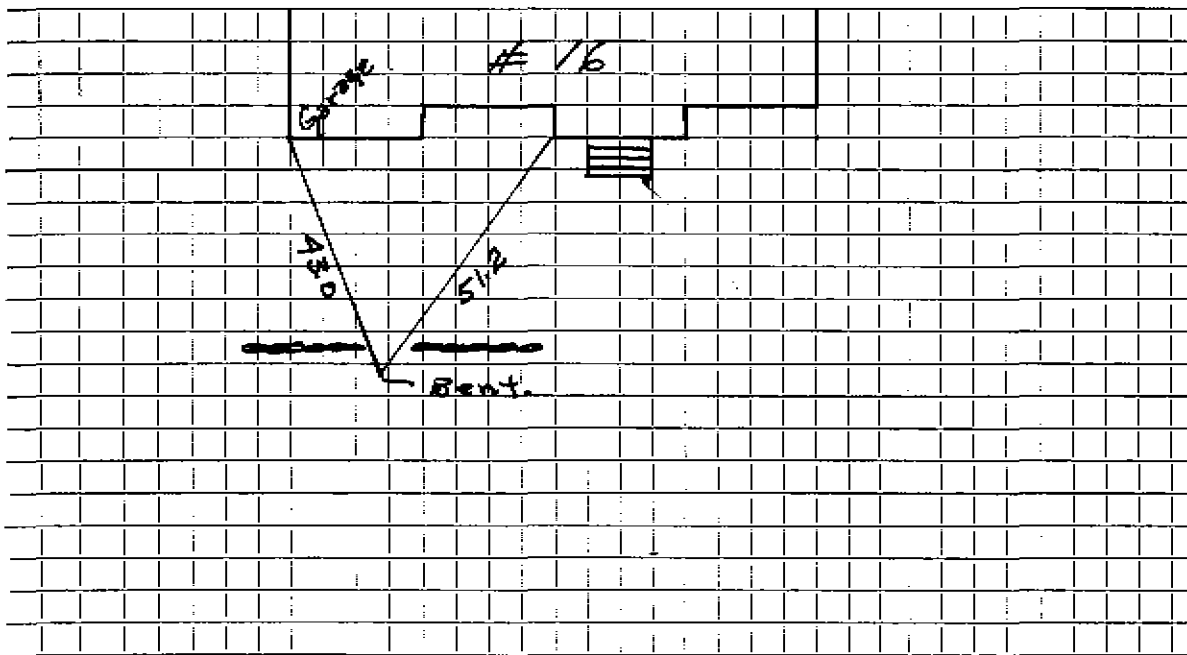

Connection made in Street. Work completed

Remarks:

.....
.....