

WATER SERVICE RECORD

Name Laeland Const. Co.

Service No. 6

Address 20 Balfour Street

#7099

Location Lexington

Repair ~~Renewal~~ New Service COM. 4-23-52


Date	Material	Amount	Total	Date	Material	Amount
3/13/52	Labor	5 35	5 35	1-23-52	Deposited	50 00
	10% overhead		54	4-28-52	Refunded	60 28
	36' - 3/4" copper tubing @ .3439	12 38			NON CHARGE	57 02
	1 - 3/4" C x 3/8 I.W.H. stop & waste	4 00		3/13/52	Labor	5 35
	2 hrs. Littlefield shovel	7 00	14 00		29' - 3/4" copper tubing @ .3439	9 97
	1 hr. trucking		75		1 - 3/4" C. corp-cock	4 33
			37 02		1 - 3/4" C x 3/4" C. curb-cock	4 67
					1 - box and rod	4 52
					1 - 1/2 straight tail piece	50
					1 - 1/2 offset tail piece	50
					2 hrs. Littlefield shovel	14 00
					1 hr. trucking	75
						44 59

DATE \_\_\_\_\_

TOWN OF LEXINGTON — BOARD OF PUBLIC WORKS

**WATER DIVISION**

Sketch of Service Here

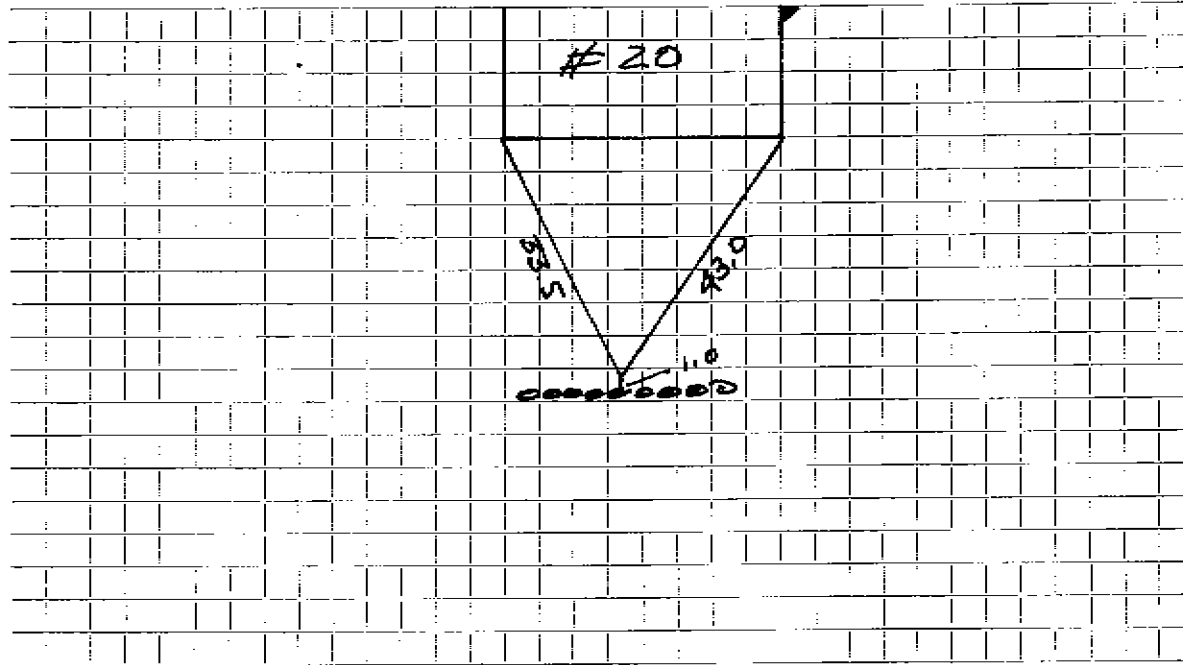

Connection made in ..... Street.                      Work completed .....

Remarks: .....

.....

.....