

WATER SERVICE RECORD

Name Leeland Const. Co.

Service No. 123

Address 21 Balfour St.

1843

Location Lexington

1009

~~Repair~~ ~~Remove~~ - New Service

am. 7-13-53


Date	Material	Amount	Total	Date	Amount
6/18/53	Labor	7 01		6-5-53 Deposited	65 00
	10% overhead	70	7 71	7-13-53 Refunded	7 84
	60' 1-3/4" Copper Tubing @.37		22 20		NON CHARGE 57 16
	1-3/4" C x 1/2" I.W.H. STOP & WASTE		4 00	6/18/53 Labor	7 02
	3 Hr. Littlefield shovel	7.50	22 50	21'-3/4" Copper Tubing .37	7 77
	1 Hr. Trucking		75	1-3/4" C. Corp-cock	4 33
			57 16	1-3/4" C x 3/4" C. Curb-cock	4 67
				1-Box & Rod	3 90
				1-1/2" straight tail piece	50
				1-1/2" offset tail piece	50
				1 Hr. Littlefield shovel	7 50
				1 Hr. Trucking	75
					<u>36 94</u>

DATE _____

TOWN OF LEXINGTON — BOARD OF PUBLIC WORKS

WATER DIVISION

Sketch of Service Here

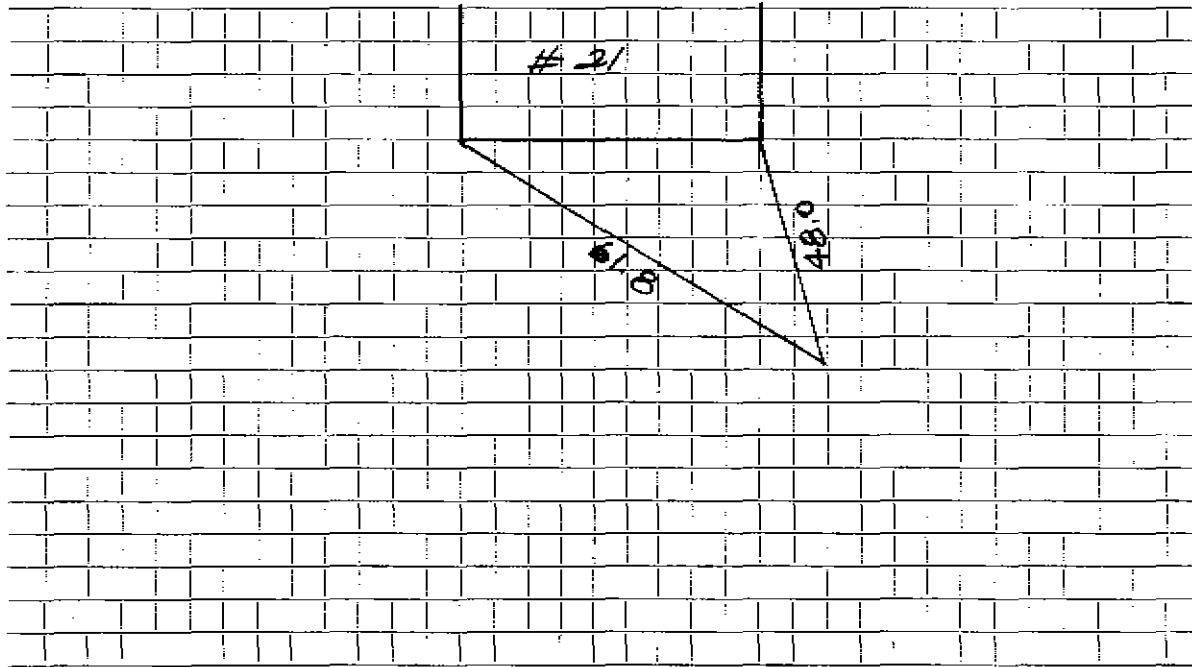

Connection made in Street. Work completed

Remarks:

.....

.....