

WATER SERVICE RECORD

Name Leeland Construction Co.

Service No. 7

Address 24 Balfour Street

#7116

Location Lexington

REPAIR/RENEWAL - New Service COM. 4-28-52


Date	Material	Amount	Total	Date	Amount
3/10/52	Labor	10 00	10 00	1-23-52	50 00
	10% overhead		1 00	4-29-52	6 50
	40' -3/4" copper tubing@.3439		13 75		43 50
	1 - 3/4" C x 1/2" I.W.H.stop& waste	4 00		3/10/52	64 10
	2 hrs. littlefield shovel		14 00	3/12/52	80 34
	1 hr. trucking		75	21' - 3/4" copper tubing@.3439	7 22
			43 50	1 - 3/4" C. corp-cock	4 33
				1 - 3/4" C x 3/4" C.curb-cock	4 67
				1 - box and rod	4 52
				27 lbs.dynamite @ .24	6 48
				26 exploders @ .136	3 53
				6 hrs. #36 compressor @ 2.75	16 50
				4 hrs. #38 compressor @ 1.75	7 00
				8 hrs. Littlefield shovel@ 7.00	56 00
				1 -1/2 offset tail piece	50
				1 -1/2 straight tail piece	50
				2 hrs. trucking	1 50
					257 19

DATE _____

TOWN OF LEXINGTON — BOARD OF PUBLIC WORKS

WATER DIVISION

Sketch of Service Here

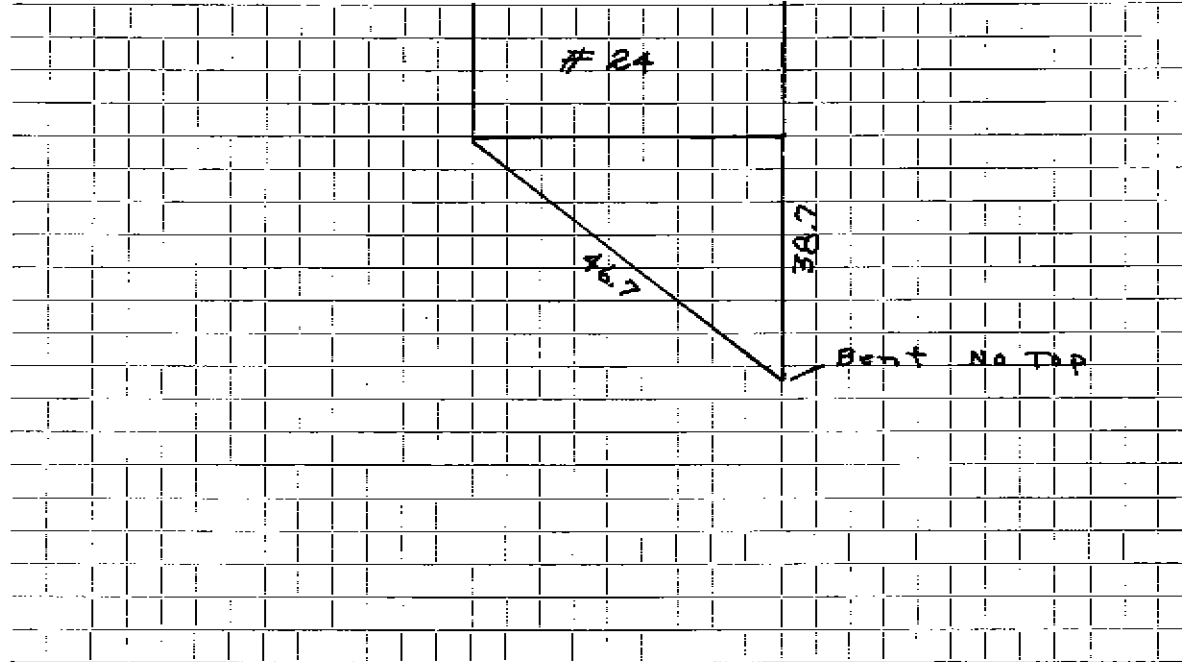

Connection made in Street. Work completed

Remarks:

.....

.....