

WATER SERVICE RECORD

Name Ieland Const. Co.

Service No. 85

Address 25 Balfour Street

Location Lexington

Repair Renewal New Service

Com. 6-16-52


Date	Material	Amount	Total	Date	Amount
5/16/52	Labor	45 73		5-13-52 Deposited	100 00
	10% overhead	4 57	50 30	6-16-52 Returned	16 04
	55' - 3/4" copper tubing @ .3439	18 91		'NON CHARGE	83 96
	1 - 3/4" C x 1/2" I.W.H. stop & waste	4 00		5/19/52 Labor	31 93
	2 hrs. town shovel @ 5.00	10 00		12' - 3/4" copper tubing @ .3439	4 12
	1 hr. trucking		75	1 - 3/4" C. corp-cock	4 33
			83 96	1 - 3/4" C x 3/4" C. curb-cock	4 67
				1 - box and rod	4 52
				1 - 1/2" offset tail piece	50
				1 - 1/2" straight tail piece	50
				20 lbs. dynamite @ .24	4 80
				17 exploders @ .15	2 55
				4 hrs. Littlefield shovel	28 00
				1 hr. trucking	75
					86 67

DATE _____

TOWN OF LEXINGTON — BOARD OF PUBLIC WORKS

WATER DIVISION

Sketch of Service Here

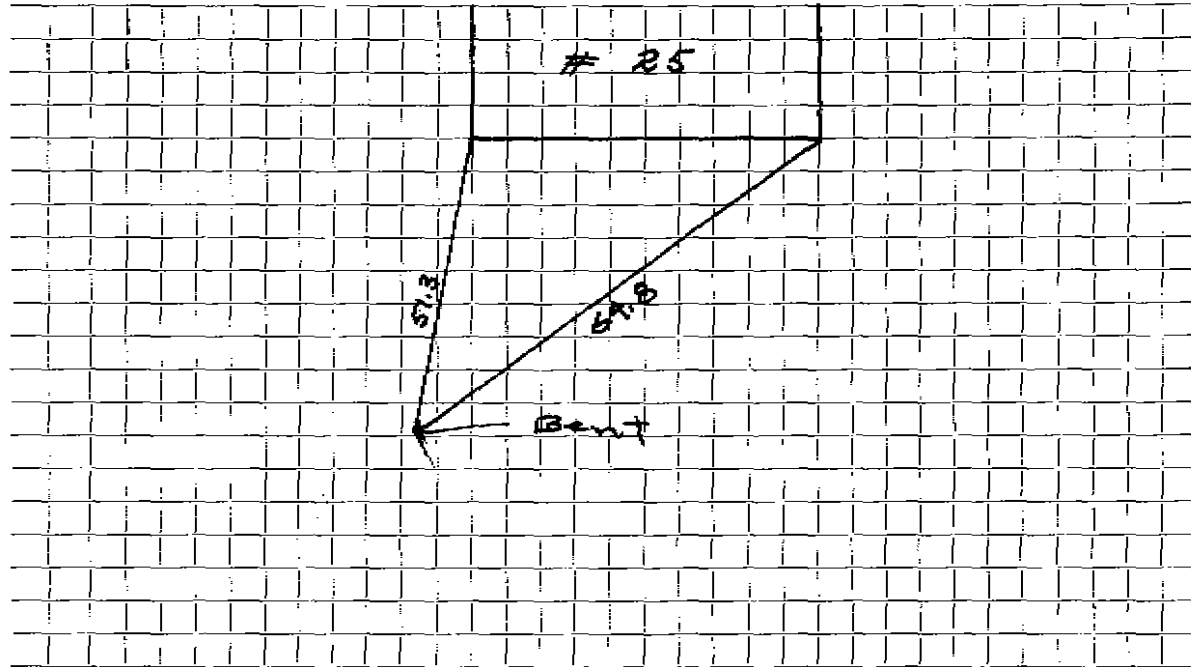

Connection made in _____ Street. Work completed _____

Remarks: _____
