


DATE _____

TOWN OF LEXINGTON — BOARD OF PUBLIC WORKS

WATER DIVISION

Sketch of Service Here

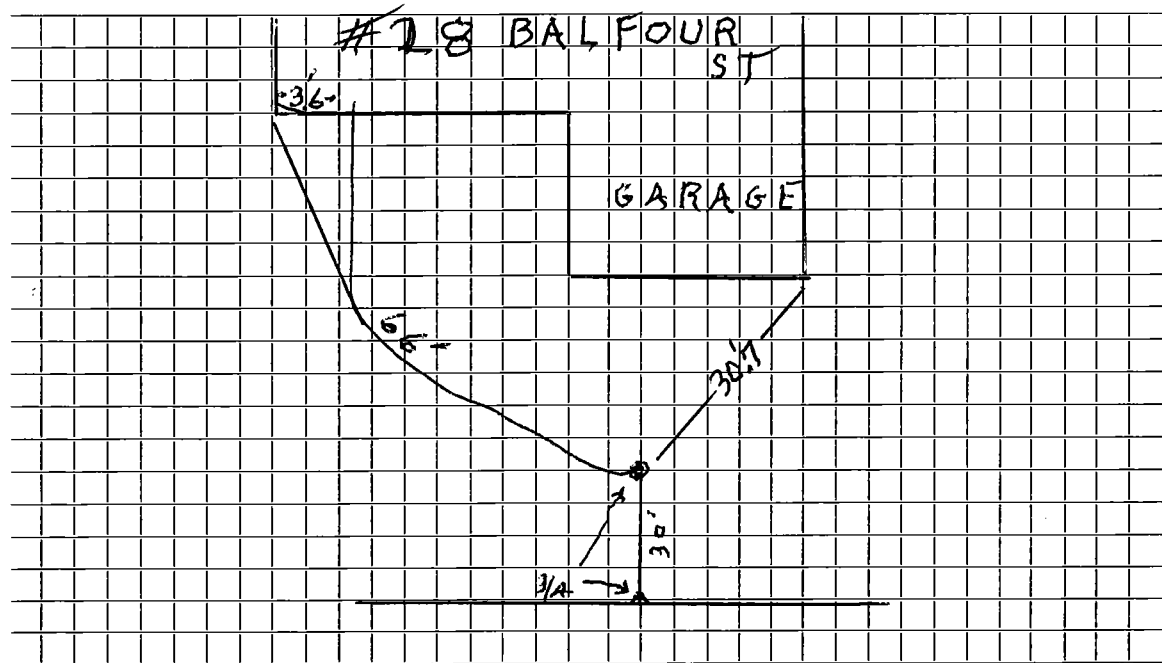

Connection made in Street.

Work completed *2012 Jim McLaughlin...*

Remarks:
.....
.....