

WATER SERVICE RECORD

Name Leeland Const.

1328

Service No. 4

Address 29 Balfour St.

Location Lexington

~~Repair~~ ~~Refrigerator~~ - New Service


COM. 2-16-53

Date	Material	Amount	Total	Date	Amount
1/6/53	Labor	17 84		1-5-53	Deposited 50 00
	10% overhead	1 78	19 62	2-16-53	Refunded * 33
	45' - 3/4" copper tubing @ .34		15 30		NON CHARGE 49 67
	1-3/4" Cx 1/2 T.W.H. stop & waste		4 00	1/7/53	Labor 12 28
	2 Hrs. Town Shovel @ 5.00		10 00	13' - 3/4" Copper Tubing @ .34	4 42
	1 Hr. Trucking		75	1-3/4" C. Corp-cock	4 33
			49 67	1-3/4" Cx 3/4" C. Gurb-cock	4 67
				1-Box & Rod	3 90
				1-1/2 Straight Tail Piece	50
				1-1/2 Offset Tail Piece	50
				1 Hr. Town Shovel @ 5.00	5 00
				1 Hr. Trucking	75
					36 35

* 1/2 of this refund made payable to Town of Lex. to apply on W.H.C. #12

TOWN OF LEXINGTON — BOARD OF PUBLIC WORKS
WATER DIVISION

Sketch of Service Here

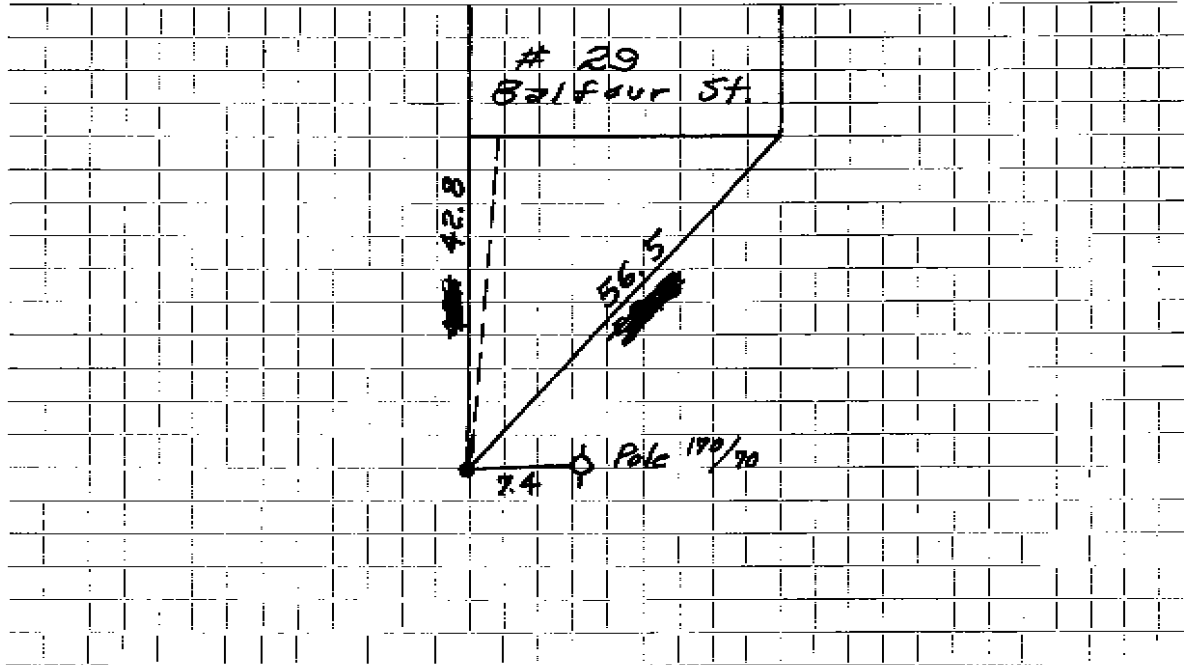

Connection made in Street. Work completed

Remarks:

.....
.....