

WATER SERVICE RECORD

Name

Service No.

Address # 33 BALFOUR ST LOTS 476-477

Location

~~Repair~~ New Service


Date	Material	Amount	Total	Date	Material	Amount	Total
8-9-61	Labor	2 04					
	10% O.H.	20	2 24				
7'	3/4" Copper Tubing @ .42		2 94				
	BILL WHEN CONNECTED		5 18				
					NON CHARGE		
				8-9-61	Labor	1 77	
					13' 3/4" Copper Tubing @ .42	5 46	
					1 3/4" C Corp Cock	4 91	
					1 3/4" Curb Cock	6 28	
					1 Box & Rod	4 90	
						23 32	

DATE _____

TOWN OF LEXINGTON — BOARD OF PUBLIC WORKS

WATER DIVISION

Sketch of Service Here

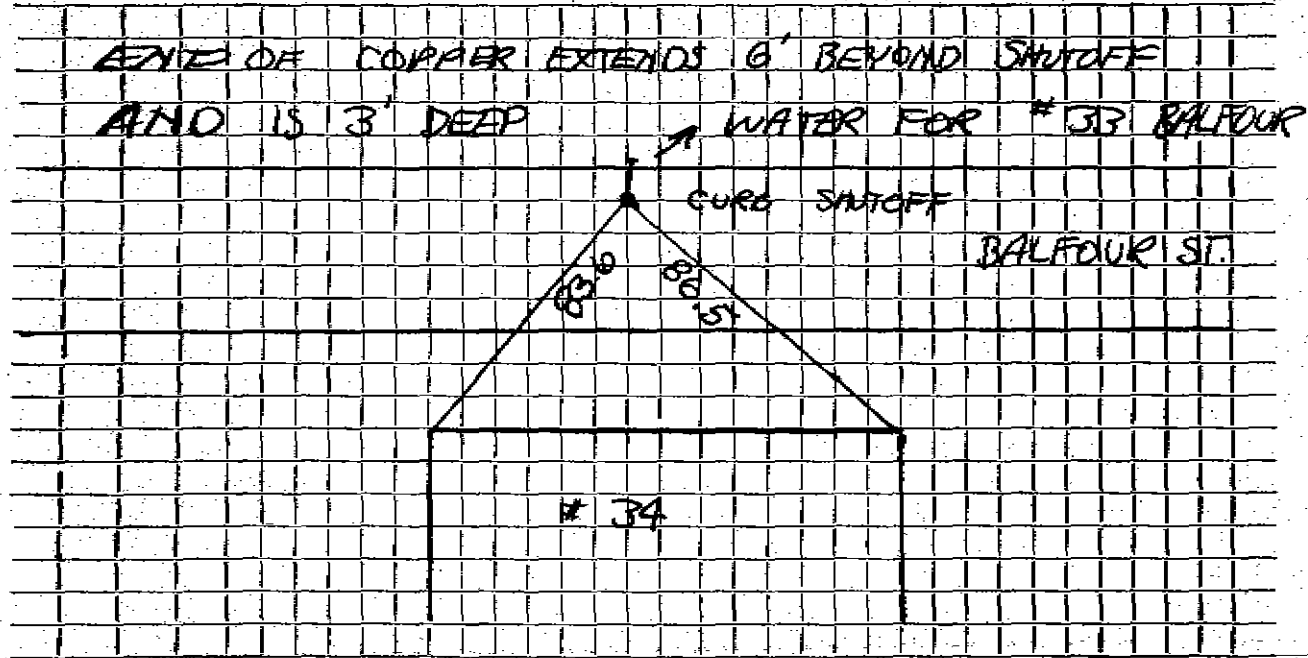

Connection made in Street. Work completed

Remarks:

.....

.....