

WATER SERVICE RECORD

Service No. 165

Name Benjamin H. Golini

Address 35 Balfour Street

# 4115

Location

~~Repair~~ - New Service


Comm. 10-29-56

Date	Material	Amount	Total	Date	Amount
6/23/56	Labor	8 30		6-19-56 Deposit	\$100.00
	10% overhead	83	9 13	10-29-56 Refund	(71 29)
	9' 3/4" Coppertubing @.4850		4 37	NON CHARGE	28 71
	1 3/4" Cx 1/2 I.W.H. Stop & Waste		4 96	48' 3/4" Coppertubing @.485	23 28
	1 hr. trucking @ .75		75	1 3/4" C. Corp Cock	4 64
	1 hr. Littlefield @9.50		9 50	1 3/4" Curb Cock	5 94
			28 71	1 Box & Rod	4 62
				1 1/2 Straight tail piece	50
				1 1/2 Offset " "	50
				1 hr Littlefield @9.50	9 50
					50 88

DATE \_\_\_\_\_

TOWN OF LEXINGTON — BOARD OF PUBLIC WORKS  
**WATER DIVISION**

Sketch of Service Here

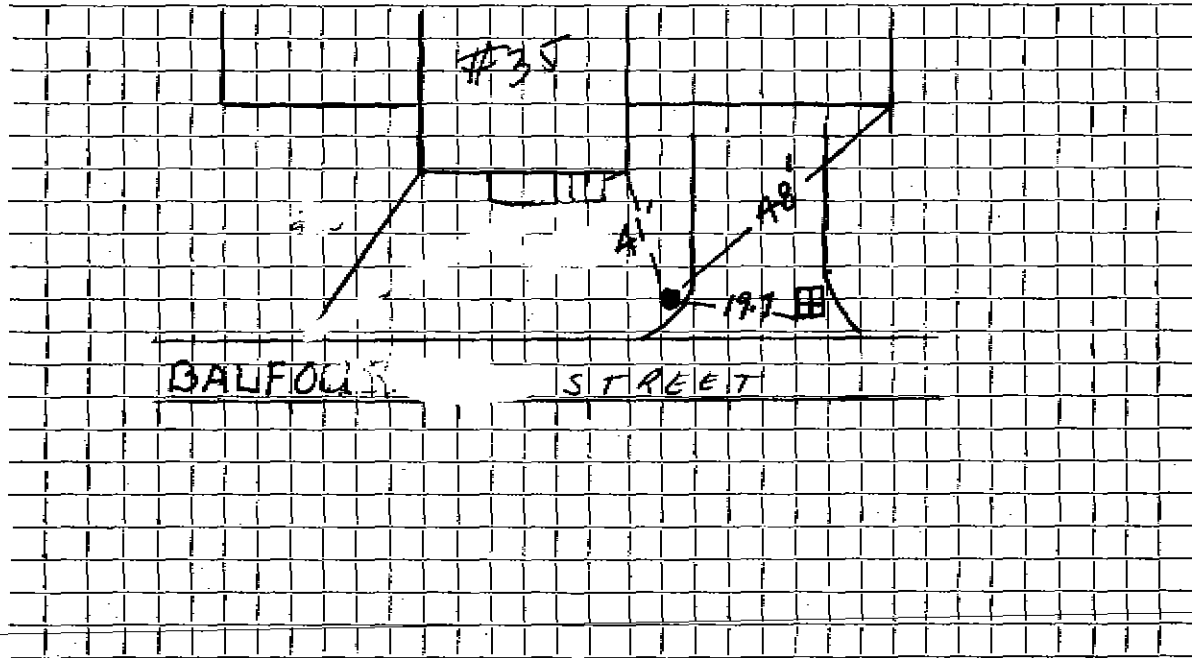

Connection made in BALFOUR ST Street. Work completed .....

Remarks: .....  
.....  
.....