

WATER SERVICE RECORD

Name Beland Const. Company

Service No. 121

Address 36 Balfour Street

Location Lexington

Repair Renewal New Service

Com. 9-29-52


Date	Material	Amount	Total	Date	Amount
9/8/52	Labor	14 12		6-25-52 Deposited	30 00
	10% Overhead	1 41	15 53	9-29-52 Refunded	7 04
	52' - 3/4" Copper tubing @ .34		17 68	NON CHARGE	42 96
	1 - 3/4" C x 1/2 I.W. H. stop & waste	4 00		9/8/52 Labor	14 13
	1 hr. town shovel @ 5.00	5 00		29' - 3/4" Copper tubing @ .34	9 86
	1 hr. trucking	75		1 - 3/4" C. corp-cock	4 33
			42 96	1 - 3/4" C x 3/4" C. curb-cock	4 67
				1 box and rod	3 90
				1 - 1/2 straight tail piece	50
				1 - 1/2 offset tail piece	50
				1 hr. town shovel @ 5.00	5 00
				1 hr. trucking	75
					43 64

DATE _____

TOWN OF LEXINGTON — BOARD OF PUBLIC WORKS

WATER DIVISION

Sketch of Service Here

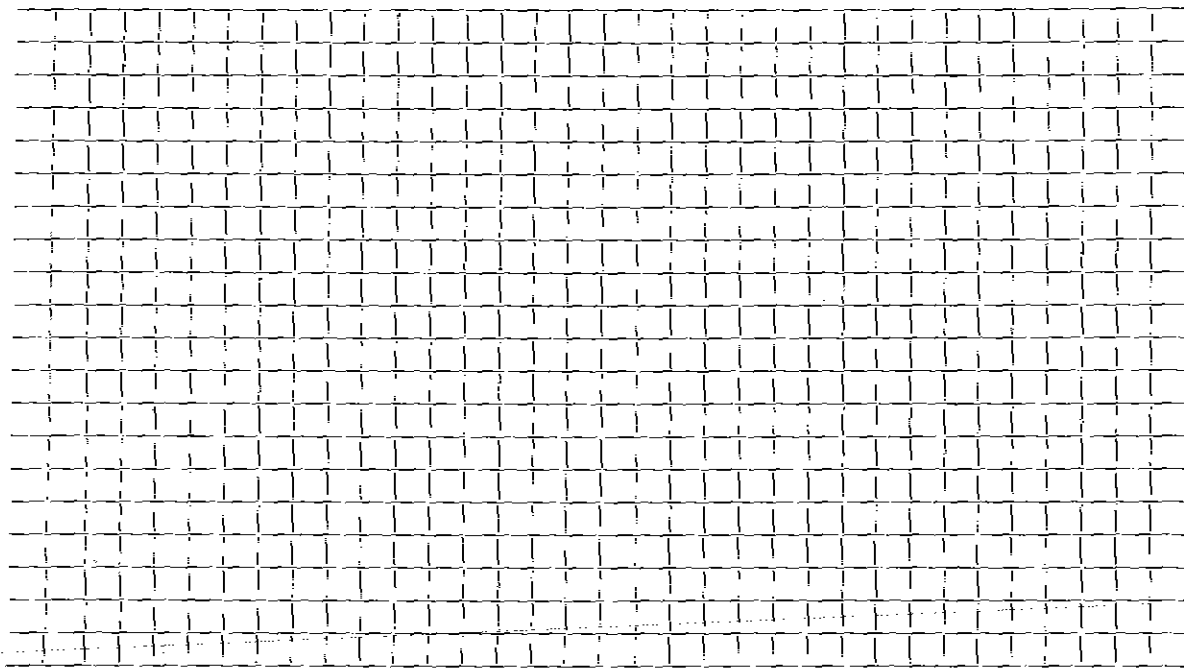

Connection made in Street. Work completed

Remarks:
.....
.....