

WATER SERVICE RECORD

2144-5
Service No.

239

Name Robert C. Oady, Jr.

Address 44 Balfour Street

Location Lexington, Mass.

~~REWORK REQUEST~~ - New Service


Com. 11-13-51

Date	Material	Amount	Total	Date	Amount
10/15/51	Labor	1 49	1 49	<i>9-24-51 Deposited</i>	<i>80 00</i>
	10% overhead		15	<i>11-13-51 Refunded</i>	<i>7 22</i>
	45' -3/4" copper tubing @ .326	14 67			<u>NON CHARGE</u>
	1 -3/4" Cx 1/2" I.W.H. stop & waste	4 00		10/15/51	Labor
	1 -3/4" Cx 3/4" Cu union (3pts.)	1 72			28' -3/4" copper tubing @ .326
	1 hr. trucking		75		1 - 3/4" C. corp-cock
			22 78		1 @ 3/4" C x 3/4" C. curb-cock
					1 - box and rod
	TRENCH DUG BY OWNER				1 - 1/2" offset tail piece
					1 - 1/2" straight tail piece
					3 hrs. Littlefield shovel @ 7.00
					1 hr. trucking
					<u>50 85</u>

DATE _____

TOWN OF LEXINGTON — BOARD OF PUBLIC WORKS
WATER DIVISION

Sketch of Service Here

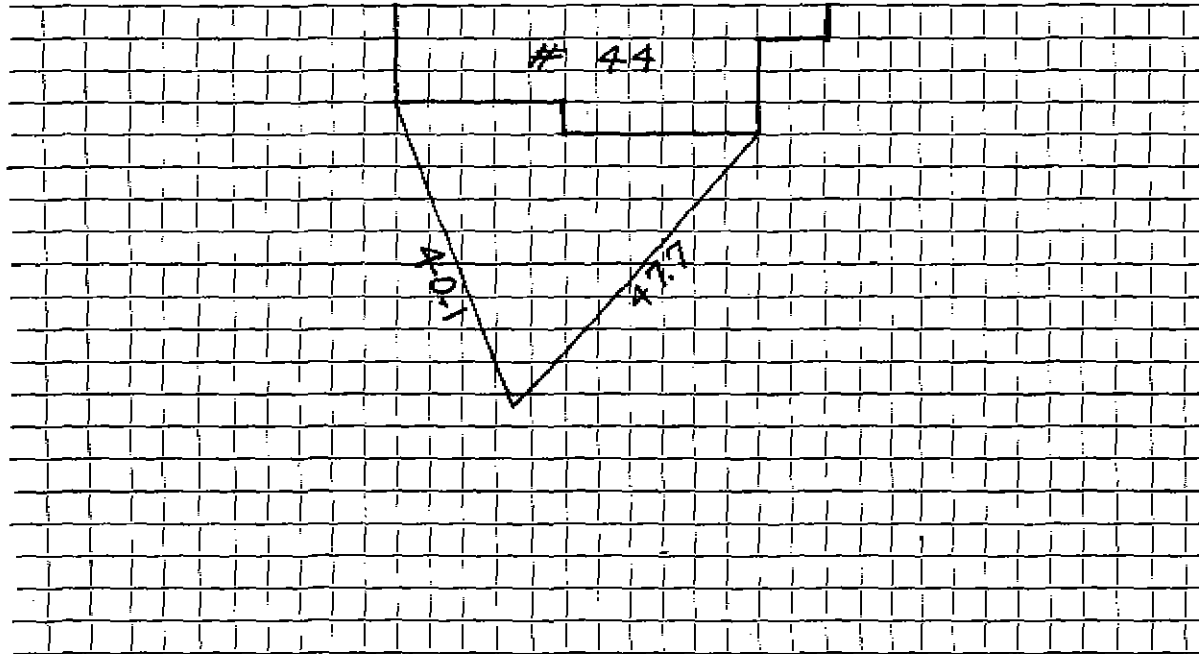

Connection made in Street. Work completed

Remarks:

.....

.....