

WATER SERVICE RECORD

Name Mrs. Edmund Cady

Service No. 337

Address 45 Balfour Street

Location Lexington, Mass.

Repair ~~Renewal~~ ~~Renewal~~ New Service Com. 12-29-52


Date	Material	Amount	Total	Date	Amount	
12/17/52	Labor	1 80		12-15-52 Deposited	30 00	
	10% Overhead	18	1 98	12-29-52 Refunded	(2 87)	
	60' - 3/4" Copper tubing@.34	20 40			NON CHARGE	
	1 - 3/4" C x 1/2 I.W.H. stop&waste	4 00		12/17/52	Labor	6 71
	1 hr. trucking		75		7' - 3/4" Copper tubing@.34	2 38
			27 13		1 - 3/4" C. Corp-cock	4 33
	TRENCH DUG BY OWNER?				1 - 3/4" C. curb-cock	4 67
					1 box and rod	3 90
					1 - 1/8 offset tail piece	50
					1 - 1/8 straight tail piece	50
					1 hr. Littlefield shovel	7 00
					1 hr. trucking	75
						30 74

DATE _____

TOWN OF LEXINGTON — BOARD OF PUBLIC WORKS

WATER DIVISION

Sketch of Service Here

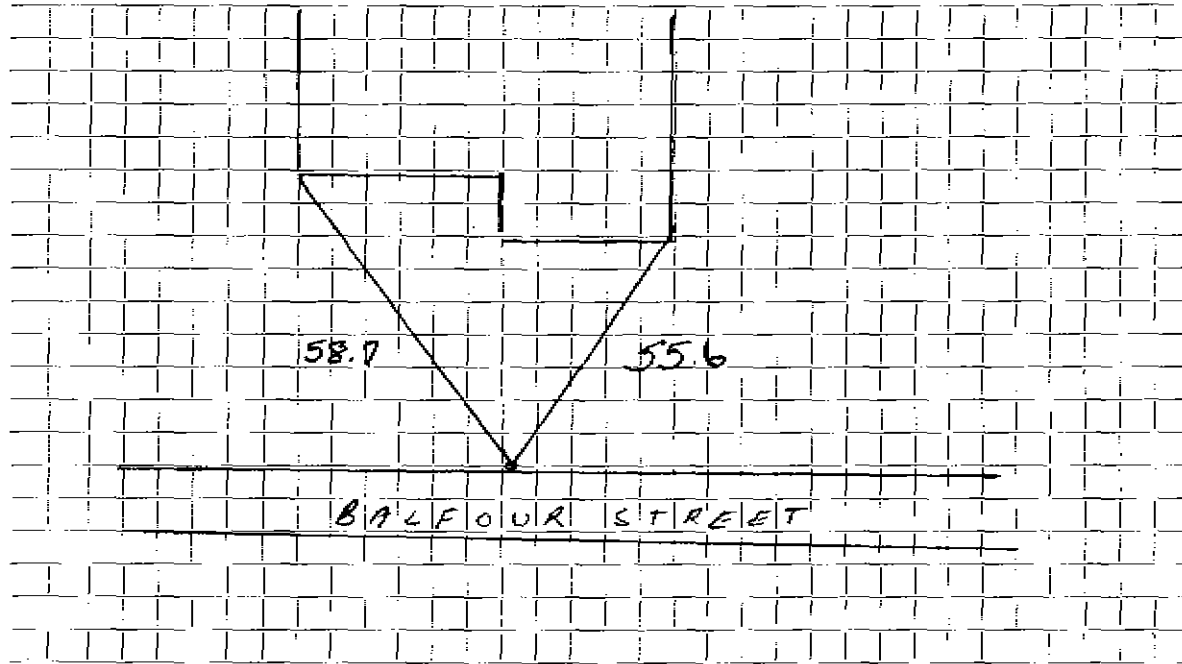

Connection made in Street. Work completed

Remarks:

.....

.....