

WATER SERVICE RECORD

#3688-

Name Leeland Const. Co.

Service No. 3

Address 5 Balfour Street

Location Lexington

Repair: ~~Renewal~~ - New Service


ORD. 2-4-52

Date	Material	Amount	Total	Date	Material	Amount
1-25-52	Labor	5 52	5 52	1-23-52	Deposited	50 00
	10% overhead		58	2-4-52	Refunded	7 99
	50' - 3/4" copper tubing @ .3439	17 19			NOT RECORDED	42 01
	1 - 3/4" C x 3/8" I.L.H. stop & waste	4 00		1-25-52	Labor	5 85
	2 hrs. Littlefield's shovel		14 00		12' - 3/4" copper tubing @ .3439	4 13
	1 hr. trucking		75		1 - 3/4" C. corp-cock	4 33
			42 01		1 - 3/4" C x 3/8" C. curb-cock	4 67
					1 box m/c rod	4 52
					1 - 1/2" straight tail piece	50
					1 - 1/2" offset tail piece	50
					1 hr. Littlefield's shovel	7 00
					1 hr. trucking	75
						32 35

DATE _____

TOWN OF LEXINGTON — BOARD OF PUBLIC WORKS
WATER DIVISION

Sketch of Service Here

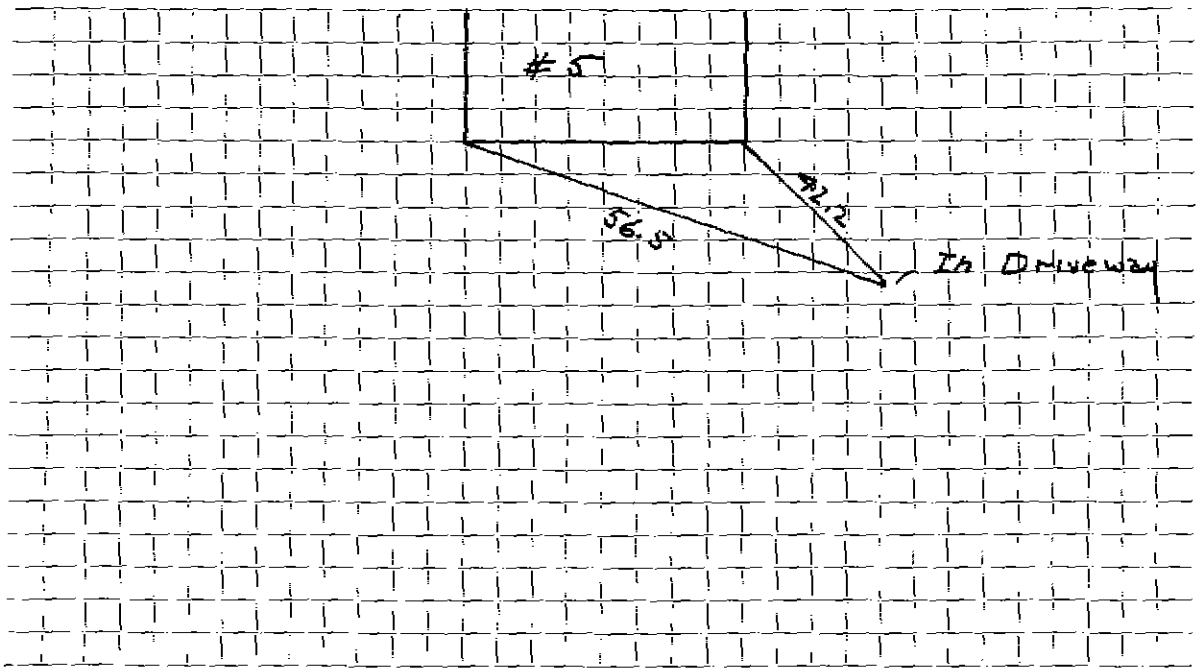

Connection made in Street. Work completed

Remarks:
.....
.....