

WATER SERVICE RECORD

290

Name Leeland Construction

Service No. 4

Address 9 Balfour Street

Location Lexington

Repair/Replacement—New Service

CON. 2-4-52


Date	Material	Amount	Total	Date	Amount.
1/25/52	Labor	5 52	5 52	1-23-52	Deposited 50 00
	10% overhead		55	2-4-52	Refunded (7 79)
	10' - 3/4" copper tubing @ .3439	17 19			NOV CHARGE 42 01
	1 - 3/4" C x 1/2" T.F. stopwaste	4 00		1/25/52	Labor 5 95
	2 hrs. Littlefield shovel	14 00			12' - 3/4" copper tubing @ .3439 4 13
	1 hr. trucking	75			1 - 3/4" C. corp-cock 4 32
			42 01		1 - 3/4" C x 3/4" C. curb-cock 4 67
					1 - box end rod 4 52
					1 - 1/2" straight tail piece 50
					1 - 1/2" offset tail piece 50
					1 hr. Littlefield shovel 7 00
					1 hr. trucking 75
					32 35

DATE \_\_\_\_\_

TOWN OF LEXINGTON — BOARD OF PUBLIC WORKS

**WATER DIVISION**

Sketch of Service Here

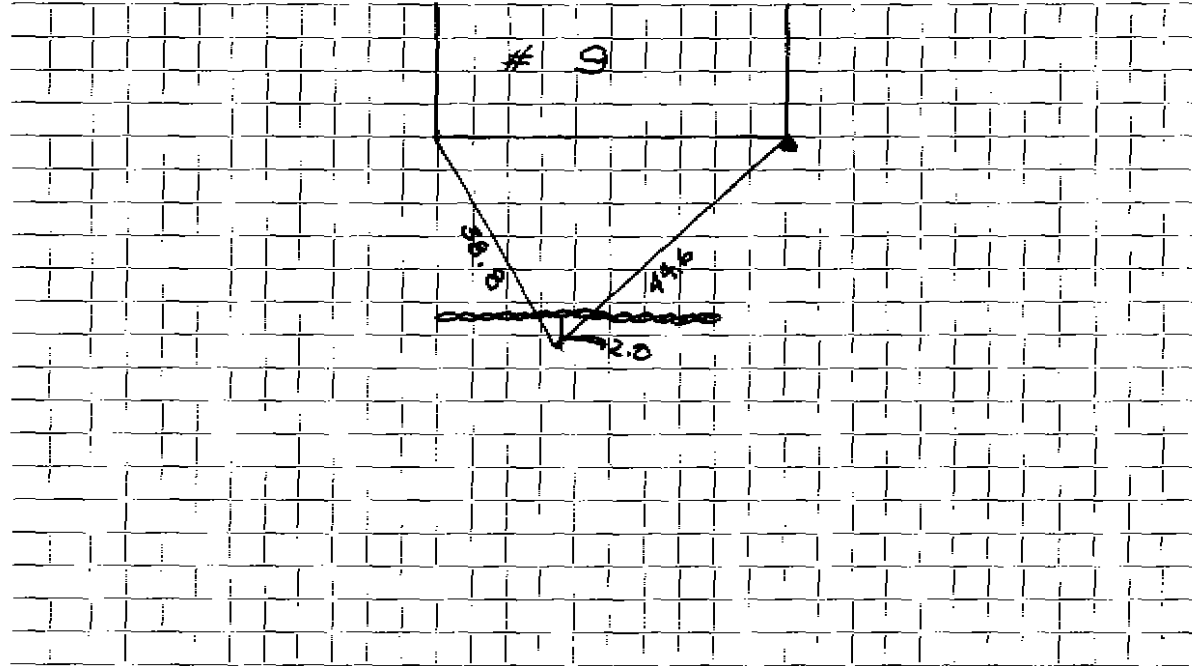

Connection made in ..... Street.                      Work completed .....

Remarks: .....

.....

.....