

WATER SERVICE RECORD

Name Waldo Maffei

Service No. 274

Address 1 Ballard Terrace

Location

Repair ~~alter~~ new Service


am 11-9-53

Date	Material	Amount	Total	Date	Material	Amount
9/17/53	Labor	1 75		9-17-53	Deposited	25 00
	10% Overhead	18	1 93	11-9-53	Refunded	1 36
	42' - 3/4" copper tubing @ .3629	15 24			NON CHARGE	23 64
	1 - 3/4" C x 1/2" I.W.H. stop & waste	4 00		9/17/53	Labor	1 50
	1 3/4" C x 3/4" C. Union Spts.	1 72			12' - 3/4" Copper tubing @ .3629	4 35
	1 hr. trucking	75			1 3/4" C. corp-cock	4 33
		23 64			1 3/4" C x 3/4" C. curb-cock	4 67
					1 box and rod	3 90
					1 - 1/2" offset tail piece	50
					1 - 1/2" straight tail piece	50
	FRANCH DUG BY OWNER				1 hr. trucking	75
						20 50

DATE _____

TOWN OF LEXINGTON — BOARD OF PUBLIC WORKS
WATER DIVISION

Sketch of Service Here

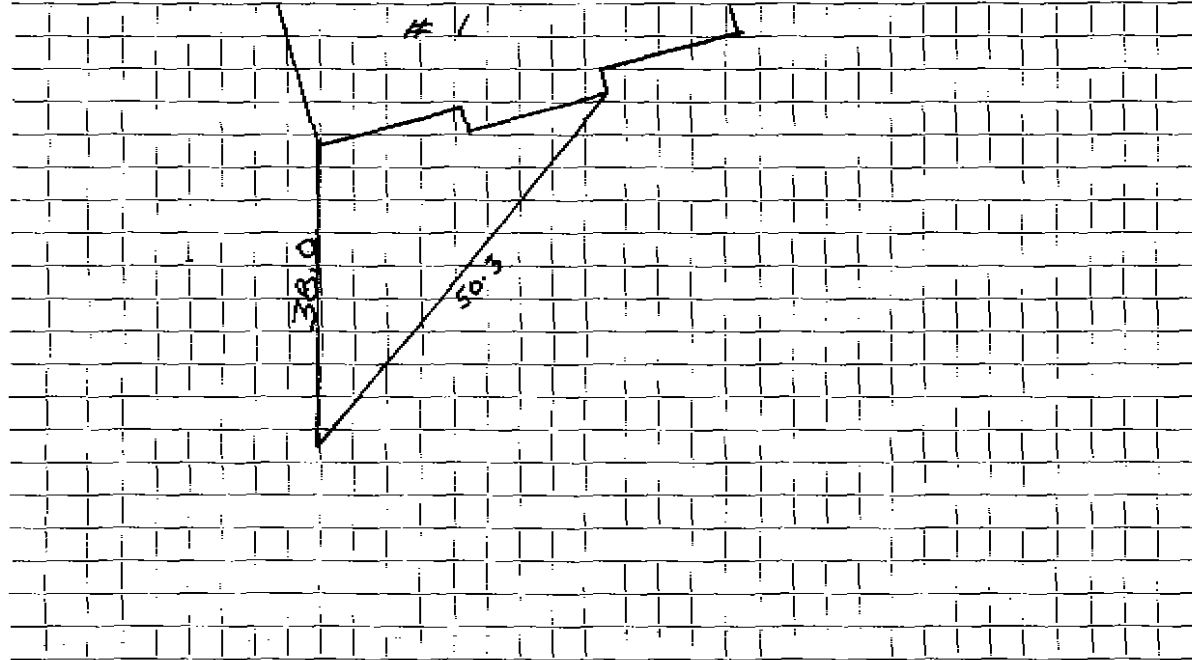

Connection made in Street. Work completed

Remarks:
.....
.....