

WATER SERVICE RECORD

Name Waldo Maffei

Service No. 284

Address 11 Ballard Terrace

Location

~~Repair~~ Renewal - New Service

Com. 11-9-53

Date	Material	Amount	Total	Date	Material	Amount
9/15/53	Labor	1 75		9-14-53		
	10% Overhead	18	1 93	11-9-53		
	40' - 3/4" Copper tubing @ .3629	14 52				
	1 - 3/4" C x 1/2" I.W.H. stop & waste	4 00		9/15/53	Labor	1 38
	1 hr. trucking		75	25' - 3/4" Copper tubing @ .3629		9 07
			21 20	1 - 3/4" C. curb-cock		4 33
				1 - 3/4" C x 3/4" C. curb-cock		4 67
				1 box and rod		3 90
	TRENCH DUG BY OWNER			1 - 1/2" offset tail piece		50
				1 - 1/2" straight tail piece		50
				1 hr. trucking		75
						25 10

*Deposited
Refunded
NON CHARGE*


*25 00
3 50
21 50*

DATE _____

TOWN OF LEXINGTON — BOARD OF PUBLIC WORKS

WATER DIVISION

Sketch of Service Here

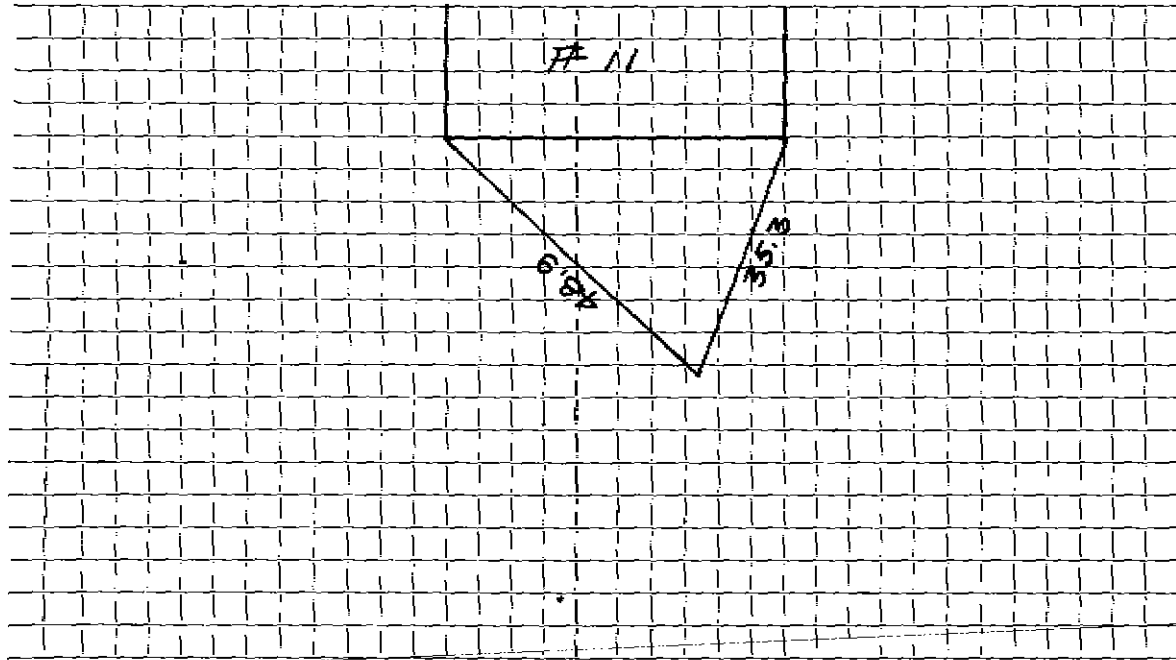

Connection made in Street. Work completed

Remarks:

.....

.....

WATER SERVICE RECORD

Name Waldo Maffei

Service No. 285

Address Ballard Terrace

#7076

Location Charged for Eng 5-30-92


~~Repair~~ ~~Renewal~~ New Service Am. 11-9-53

Date	Material	Amount	Total	Date	Amount
9/15/53	Labor	1 75		9-14-53 Deposited	20 00
	10% Overhead	18	1 93	11-9-53 Paid	(5 17)
	60' - 3/4" Copper tubing @ .3629	21 77		NOV CHARGE	30 17
	1 - 3/4" C x 1/2 I/W.H. stop & waste	4 00		9/15/53 Labor	1 38
	1 - 3/4" C x 3/4" C. union 3 pts.	1 72		53' - 3/4" Copper tubing @ .3629	19 23
	1 hr. trucking		75	1 - 3/4" C. corp-cock	4 33
			30 17	1 - 3/4" C x 3/4" C. curb-cock	4 67
	TRENCH DUG BY OWNER			1 - 3/4" C x 3/4" C. Union 3 pts.	1 72
				1 box sand rod	3 90
				1 - 1/2 offset tail piece	50
				1 - 1/2 straight tail piece	50
				1 hr. trucking	75
					36 98

DATE _____

TOWN OF LEXINGTON — BOARD OF PUBLIC WORKS
WATER DIVISION

Sketch of Service Here

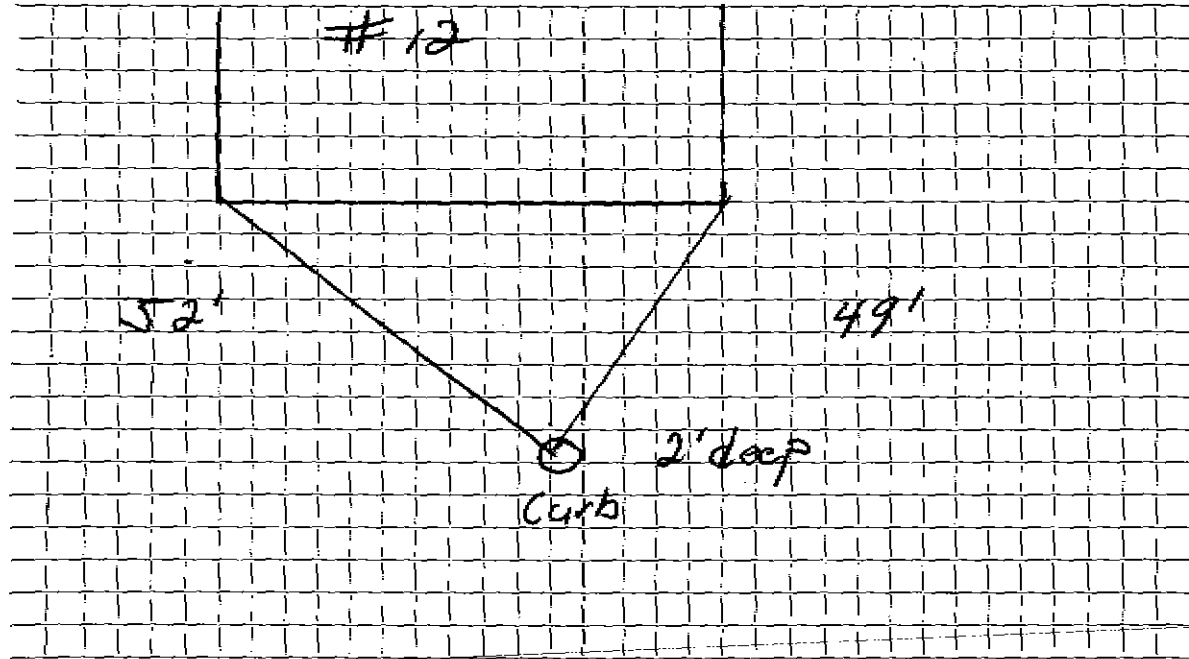

Connection made in Street, Work completed

Remarks:

.....
.....