

WATER SERVICE RECORD

Name **Waldo Maffei**

Service No. **275**

Address **2 Ballard Terrace**

3120

Location

6731

~~Repair - Renewal -~~ New Service

Com. 11-9-53


Date	Material	Amount	Total	Date	Amount
9/17/53	Labor	1 75		9-14-53 Deposited	25 00
	10% Overhead	18	1 93	11-9-53 Refunded	1 99
	45' - 3/4" Copper tubing @.3629	16 33			NON CHARGE
	1 - 3/4" C x @I.W.H.stop&waste	4 00		9/17/53 Labor	1 50
	1 hr. trucking		75	24' - 3/4" Copper tubing@.3629	8 71
			<u>23 01</u>	1 - 3/4" C. corp-cock	4 33
				1 - 3/4" C. curb-cock	4 67
				1 box and rod	3 90
				1-1/2 straight tail piece	50
				1-1/2 offset tail piece	50
				1 hr. trucking	75
					<u>24 66</u>
	TRANCE DUC BY OWNER				

DATE _____

TOWN OF LEXINGTON — BOARD OF PUBLIC WORKS

WATER DIVISION

Sketch of Service Here

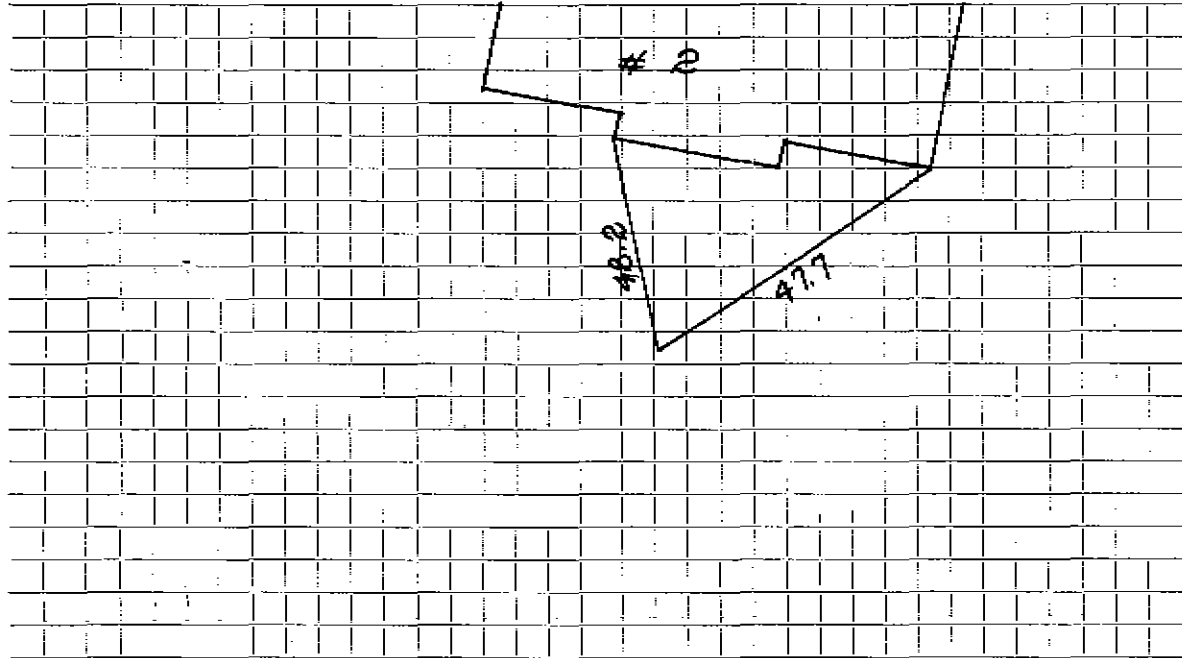

Connection made in Street. Work completed

Remarks:
.....
.....