

WATER SERVICE RECORD

Name BUILDING SOLUTION LTD.

Service No.

Address #4 BALLARD TERRACE

Location

Repair Renewal New Service PERMIT NO. 0921 - J.M. MCLAUGHLIN


Date	Material	Amount	Total	Date	Amount
2/10/97	48' - 1" ϕ COPPER				
				9-15-53	
				22' $\frac{3}{4}$ " Copper	
				1 $\frac{3}{4}$ " C. Corp Cock	
				1 $\frac{3}{4}$ " C. X $\frac{3}{4}$ " C. Curb Cock	

DATE FEBRUARY 10, 1997

TOWN OF LEXINGTON — BOARD OF PUBLIC WORKS

WATER DIVISION

Sketch of Service Here

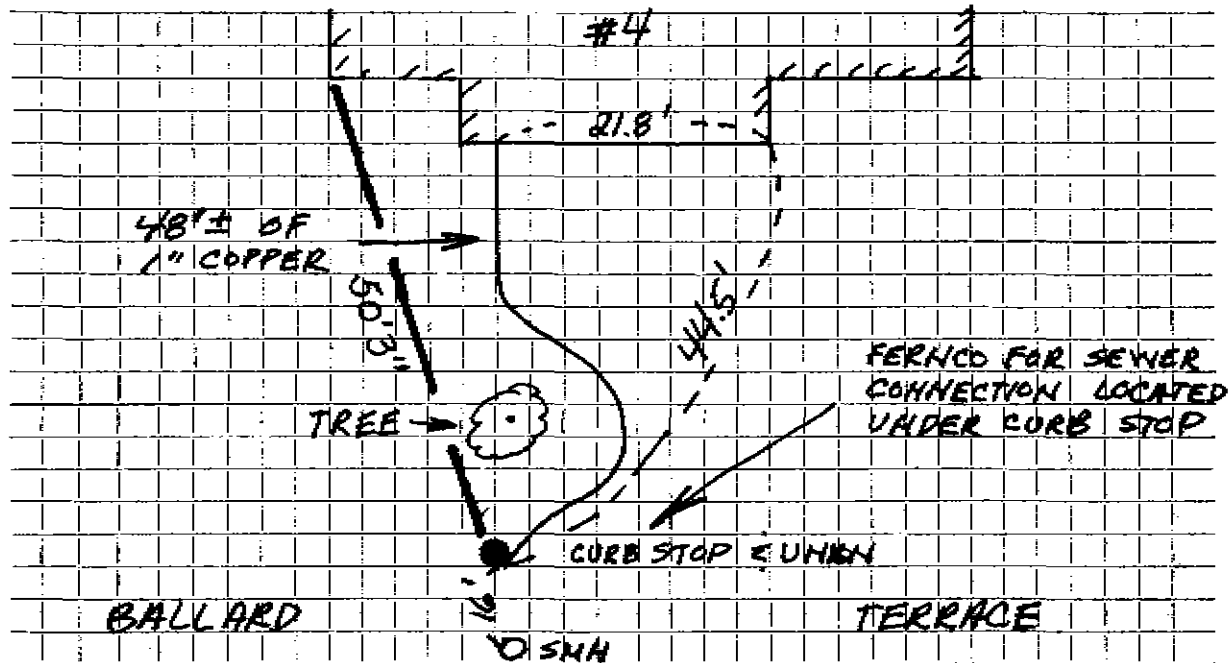

Connection made in BALLARD TERRACE Street. Work completed

Remarks: