

WATER SERVICE RECORD

Name

Service No.

Address

Location 6 BALLARD TERR


Repair ~~Renewal~~ ~~New~~ Service MCIVE ✓

| Date | Material | Amount | Total | Date | Material | Amount |
|---------|------------------|--------|---------|-------|------------|--------|
| 12/9/99 | 45' 1" COPPER | | 9/10/53 | 0MT | | |
| | 1 3/4 x 1" UNION | | 22 | 3/4 | COPPER | |
| | 1 BUFFALO BOX | | | 1 3/4 | CORP | |
| | 1 1" VALVE | | | 1 3/4 | CUM 6 STOP | |

DATE _____

TOWN OF LEXINGTON — BOARD OF PUBLIC WORKS
WATER DIVISION

Sketch of Service Here
6 BALLARD TERR.

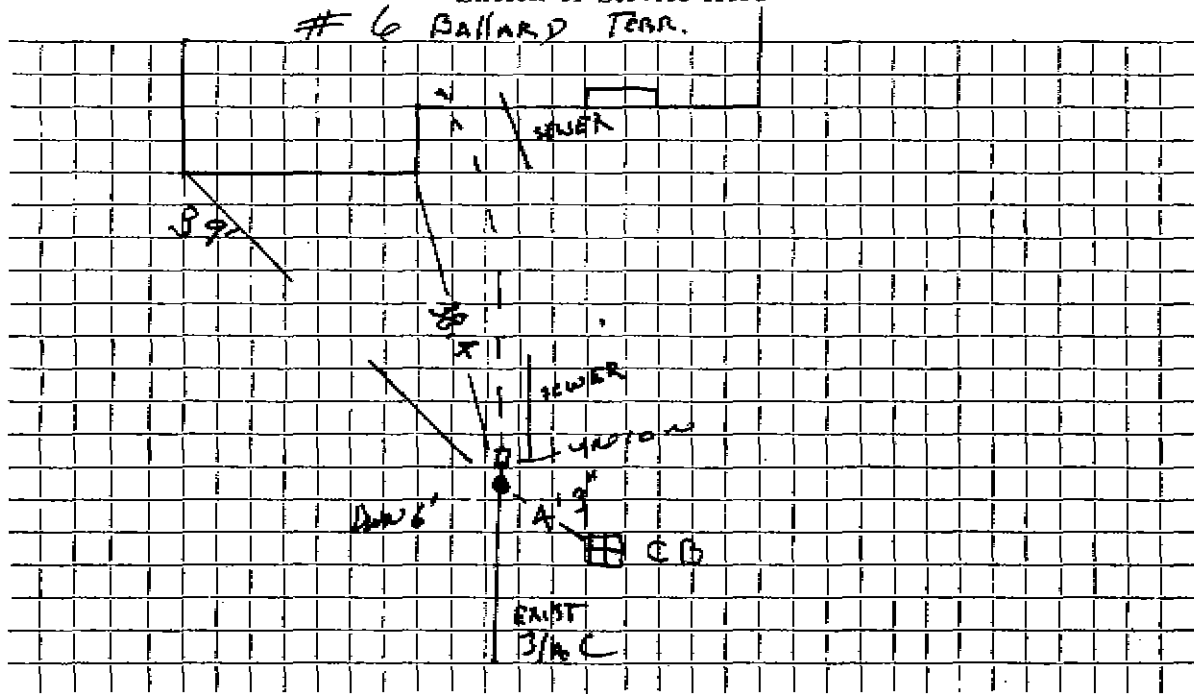

Connection made in _____ Street. Work completed _____

Remarks: *SEWER SAME TRENCH 1' APART*

.....

.....