

#379

WATER SERVICE RECORD

Name Waldo Maffei

Service No. 280

Address 7 Ballard Terrace

Location

Repair ~~Renewal~~ New Service


Com. 11-9-53

Date	Material	Amount	Total	Date	Amount
9/15/53	Labor	1 75		9/15/53	25 00
	10% Overhead	18	1 93	11-9-53	3 08
	42' - 3/4" Copper tubing @ .3629		15 24		21 92
	1 - 3/4" C x 1/2" I.W.H. stop & waste	4 00		9/15/53	Labor
	1 hr. tracking		75	12' - 3/4" Copper tubing @ .3629	4 35
			21 92	1 - 3/4" C. corp-cock	4 33
				1 - 3/4" C x 3/4" C. curb-cock	4 67
				1 box and rod	3 90
				1 - 3/8" straight tail piece	50
				1 - 3/8" offset tail piece	50
				1 hr. tracking	75
					20 33
	TRENCH DUG BY OWNER				

DATE _____

TOWN OF LEXINGTON — BOARD OF PUBLIC WORKS
WATER DIVISION

Sketch of Service Here

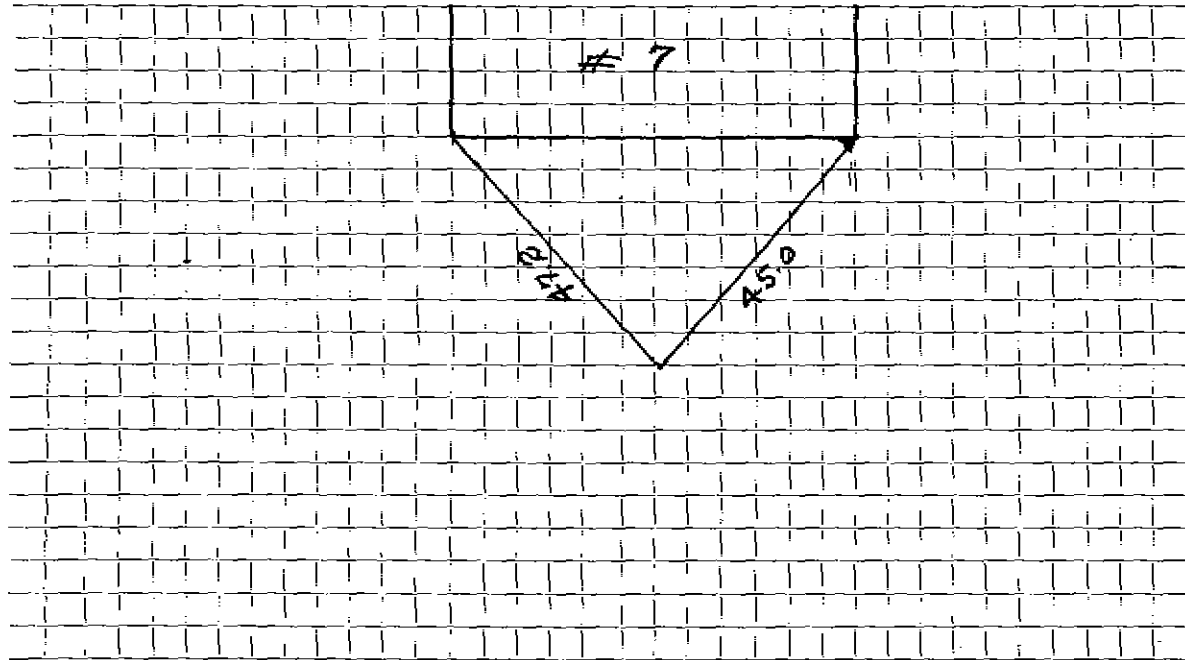

Connection made in Street. Work completed

Remarks:

.....

.....