

WATER SERVICE RECORD

Service No. 281

Name Waldo Maffei

Address 8 Ballard Terrace

Location

Repair ~~Renewal~~ New Service

Com. 11-9-53


Date	Material	Amount	Total	Date	Amount
9/15/53	Labor	1 75		9-14-53 Deposited	25 00
	10% Overhead	18	1 93	11-9-53 Refunded	1 99
	45' - 3/4" Copper tubing @ .3529	16 33			23 01
	1 - 3/4" Cx 1 I.W.H. stop & waste	4 00		9/15/53 Labor	1 38
	1 hr. trucking	75		22' - 3/4" Copper tubing @ .3529	7 98
			23 01	1 - 3/4" C. corp-cock	4 33
				1 - 3/4" C x 3/4" C. curb cock	4 67
				1 box and rod	3 90
	TRANCE DIG BY OWNER			1 - 1/2" straight tail piece	50
				1 - 3/4" offset tail piece	50
				1 hr. trucking	75
					24 01

DATE _____

TOWN OF LEXINGTON — BOARD OF PUBLIC WORKS

WATER DIVISION

Sketch of Service Here

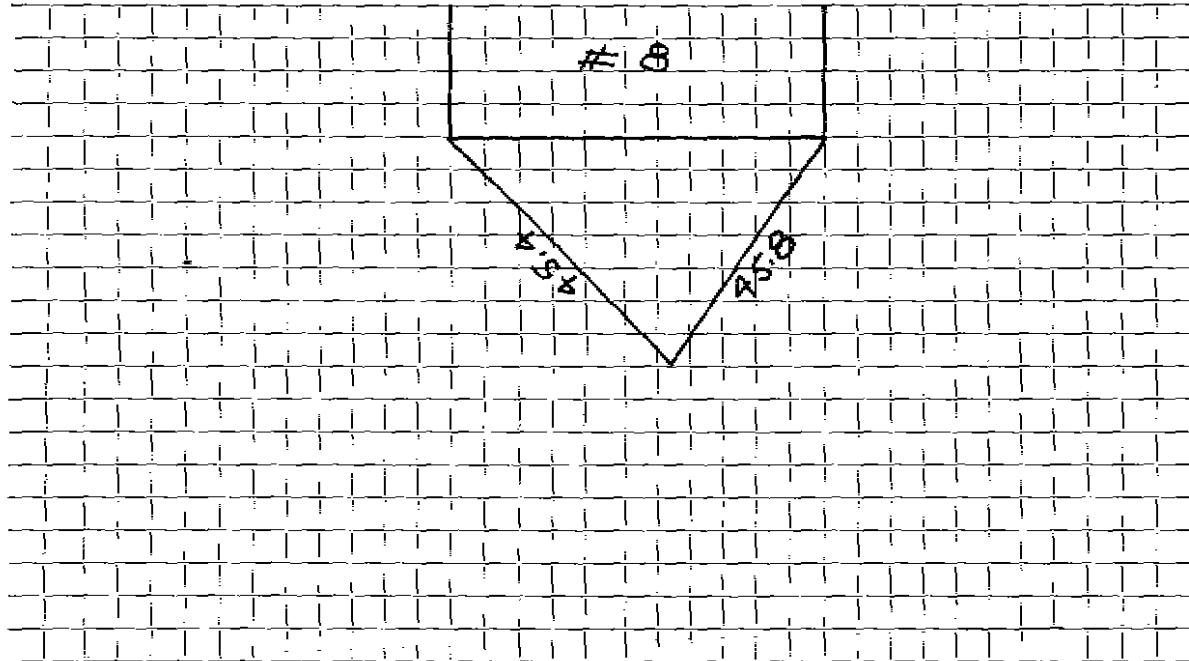

Connection made in Street. Work completed

Remarks:
.....
.....