

WATER SERVICE RECORD

Service No. 282

Name Waldo Maffei

Address 9 Ballard Terrace

2512, #7603

Location

Repair—Renewal—New Service


Sum 11-9-53

Date	Material	Amount	Total	Date	Amount	
9/15/53	Labor	1 75		9-15-53	<i>Deposited Refunded NON CHARGE</i>	
	10% Overhead	18	1 93	11-9-53		
	42' - 3/4" Copper tubing @ .3629		15 24	9/15/53	Labor	1 38
	1 - 3/4" C x I.W.H. stop & waste		4 00	12' - 3/4" Copper tubing @ .3629		4 35
	1 hr. trucking		75	1 - 3/4" C. corp-cock		4 33
			21 92	1 - 3/4" C x 3/4" C. curb cock		4 67
				1 box and rod		3 90
				1 - 1/2 straight tail piece		50
				1 - 1/2 offset tail piece		50
	TRENCH DUG BY OWNER			1 hr. trucking		75
						20 38

DATE _____

TOWN OF LEXINGTON — BOARD OF PUBLIC WORKS
WATER DIVISION

Sketch of Service Here

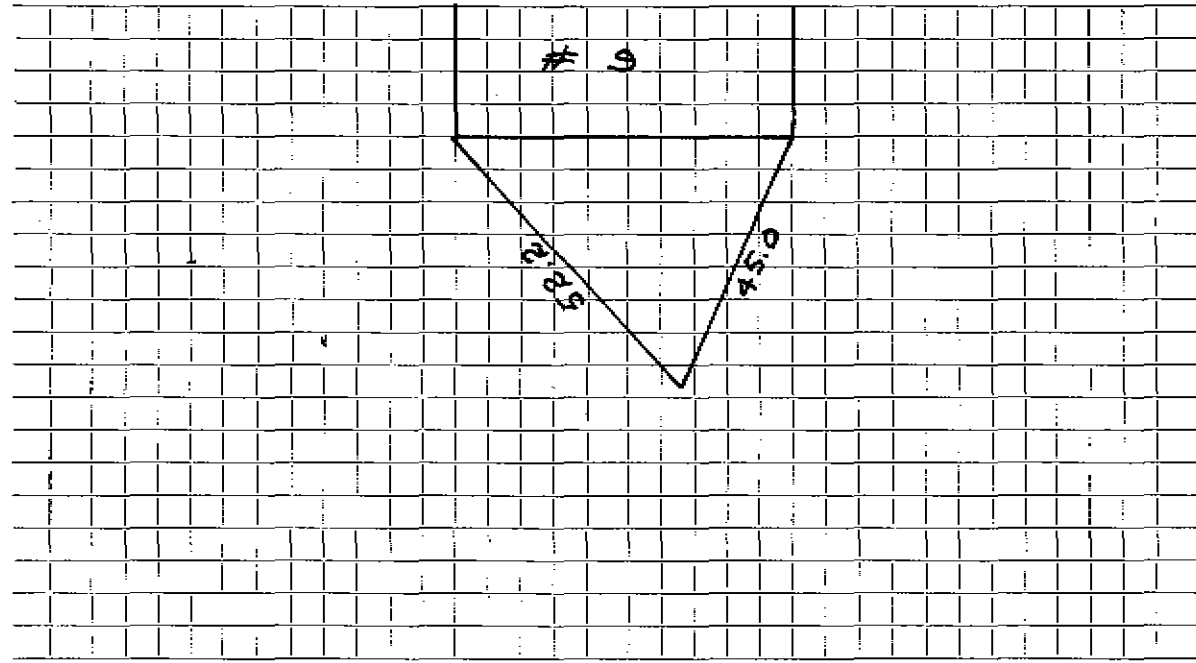

Connection made in Street. Work completed

Remarks:
.....
.....