




DATE 11/8/16

TOWN OF LEXINGTON — BOARD OF PUBLIC WORKS  
WATER DIVISION

Sketch of Service Here

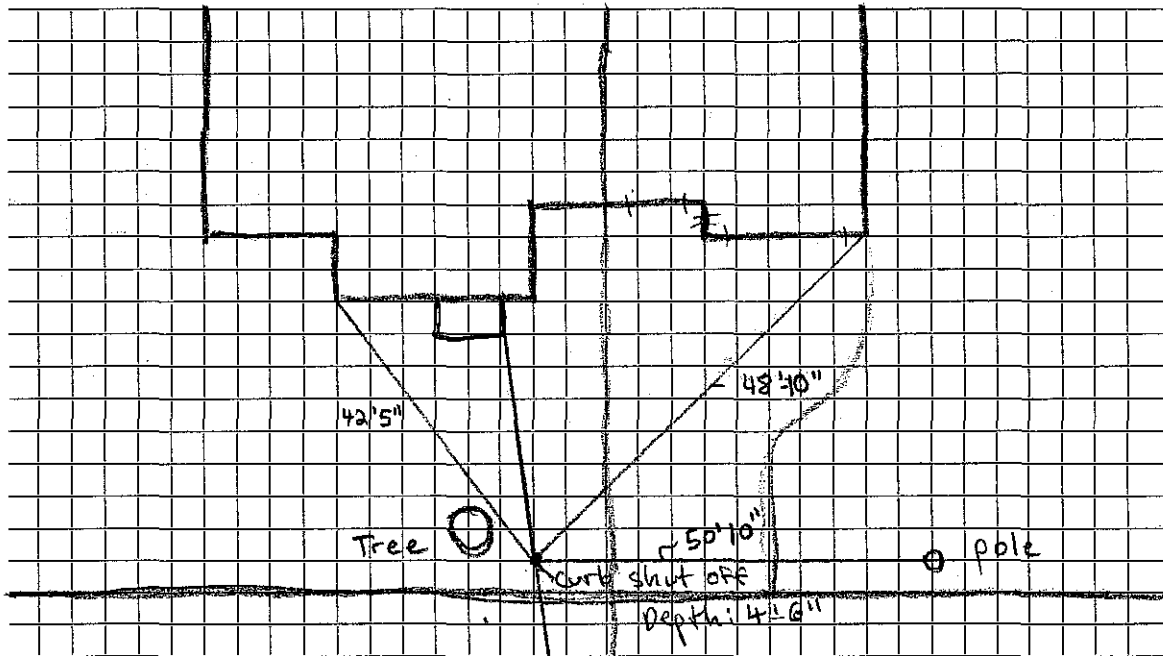

Connection made in 5 Ballard Terrace Street. Work completed .....

Remarks: Water is to right of sewer till it ~~crosses~~ Reaches house crosses at the wye for cleanout  
... Replaced Buffalo Box while repairing sewer (was in tree roots)