

WATER SERVICE RECORD

Name Donald B. Banks

Service No. 20

Address 10 Banks Rd.

Location

~~REPAIR-Renewal-NEW SERVICE~~

Comm 6-1-59


Date	Material	Amount	Total	Date		Amount
4-17-59	Labor	13.53		4-3-59	Deposit	100 00
	10% O.H	1.35	14.88	6-1-59	Refund	57 77
	28' 3/4" Copper tubing @.3666		10.26			42 23
	1 3/4" C x 1/2 I.W.H. Stop & Waste		5.84		NON CHARGE	
	1 1/2 Hr. Town Shovel @6.50		9.75		Labor	9.67
	2 hrs. Trucking @.75		1.50		20' 3/4" copper tubing @.3666	7.33
			42.23		1 3/4" C Curb Cock	6.03
					1 3/4" C Corp Cock	4.64
					1 Box & Rod	5.00
					1 1/2 Straight tail piece	.50
					1 1/2 Offse tailpiece	.50
					1/2 hr. Town Shovel @ 6.50	3.25
					1 hr. Trucking @.75	.75
						37.67

DATE _____

TOWN OF LEXINGTON — BOARD OF PUBLIC WORKS

WATER DIVISION

Sketch of Service Here

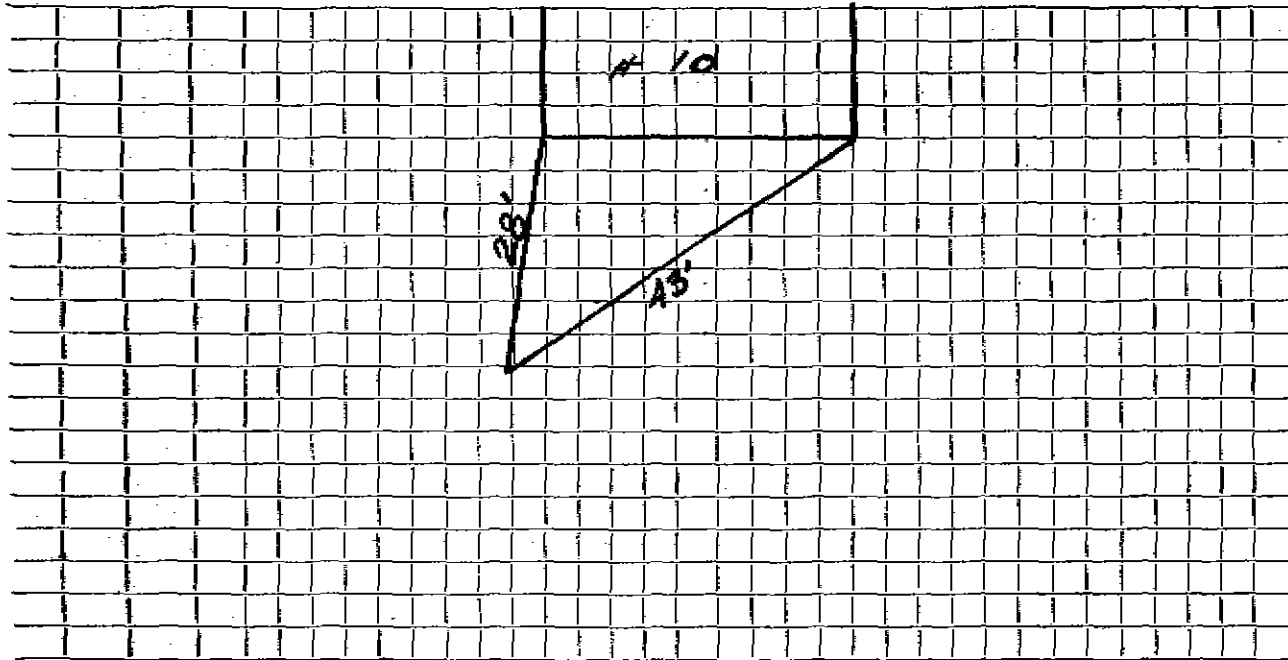

Connection made in Street. Work completed

Remarks:

.....

.....