

WATER SERVICE RECORD

Name Joseph Potzka

Service No. 5

Address 14 Banks Avenue

Location

~~Repair~~—Renewal—~~New Service~~ W. O. #619

MAY 29 1973


Date	Material	Amount	Total	Date	Amount	
3-27-73	Labor	67 20		3-9-73	Deposit	200 00
	10% O. H.	6 72	73 92	5-29-73	Refund	57 15
	48' 3/4" Coper Pipe .79		37 92			142 85
	1 3/4" wheel valve		12 01			
	2 hours truck @ 3.00		6 00			
	2 hours shovel @6.50		13 00			
			142 85		RENEWAL OUTSIDE	
				5/19/59	Labor	14 50
				5/20/59	Labor	23 50
				20'	3/4" Copper Tubing @ .3666	7 33
				1	3/4" C Adapter	1 95
				1	3/4" C Curb Cock	6 03
				1	1" LL Coupling	54
				1	Box & Rod	5 00
				2 Hrs.	pippin Shovel @ 4.50	9 00
				1 Hr.	Trucking @ .75	75
						68 60

DATE _____

TOWN OF LEXINGTON — BOARD OF PUBLIC WORKS

WATER DIVISION

Sketch of Service Here

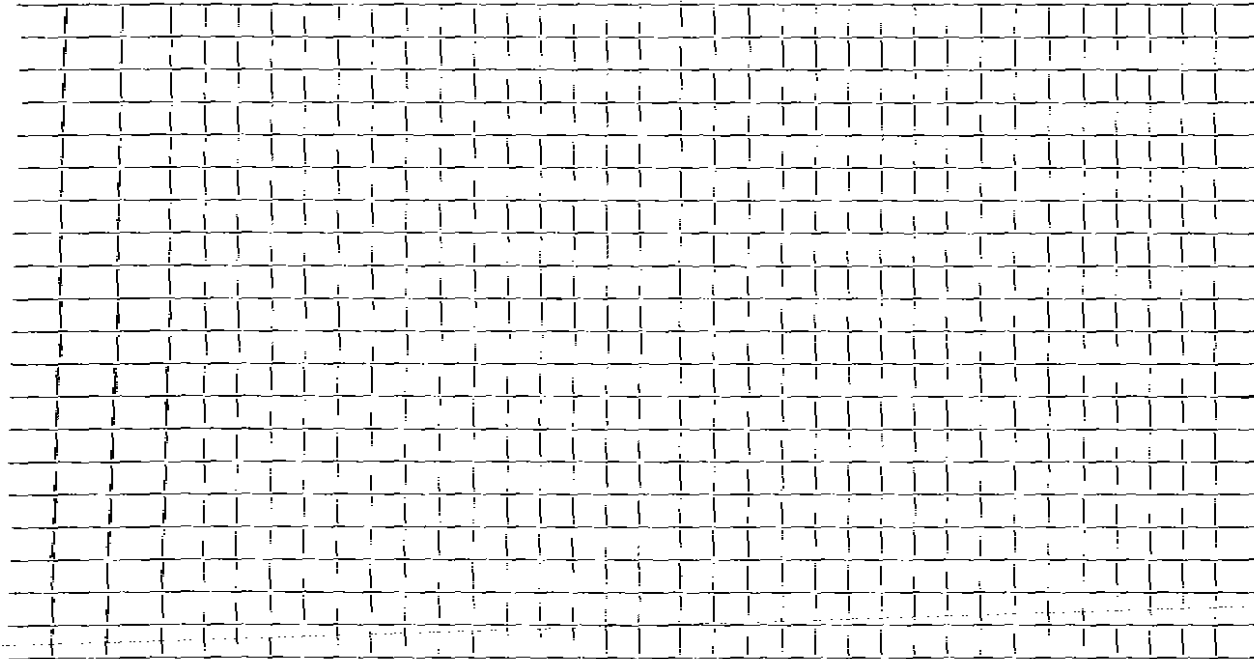

Connection made in Street. Work completed

Remarks:

.....

.....