

WATER SERVICE RECORD

Name William Sullivan

Service No. 1

Address 15 Banks Avenue

3530

Location

~~Repair~~ ~~Renewal~~ ~~New Service~~

Comm. 6-2-58


Date	Material	Amount	Total	Date	Amount
12/20/57				1-6-58	Deposit \$35.00
35' - 3/4"	Copper tubing @ .37		12 95	6-2-58	Refund
1 - 3/4"	Cx 1/2 I.W.H. Stop & Waste		4 96		(17 09)
			17 91		\$17 91
					NON CHARGE
				15' - 3/4"	Copper tubing @ .37 5 55
				1 - 3/4"	C. Corp Cock 4 64
				1 - 3/4"	C. Curb Cock 5 94
				1	Box & Rod 4 62
				1 - 1/2	Straight tailpiece 50
				1 - 1/2	Offset tailpiece 50
	Owner dug trench and laid copper				21 75

DATE _____

TOWN OF LEXINGTON — BOARD OF PUBLIC WORKS

WATER DIVISION

Sketch of Service Here

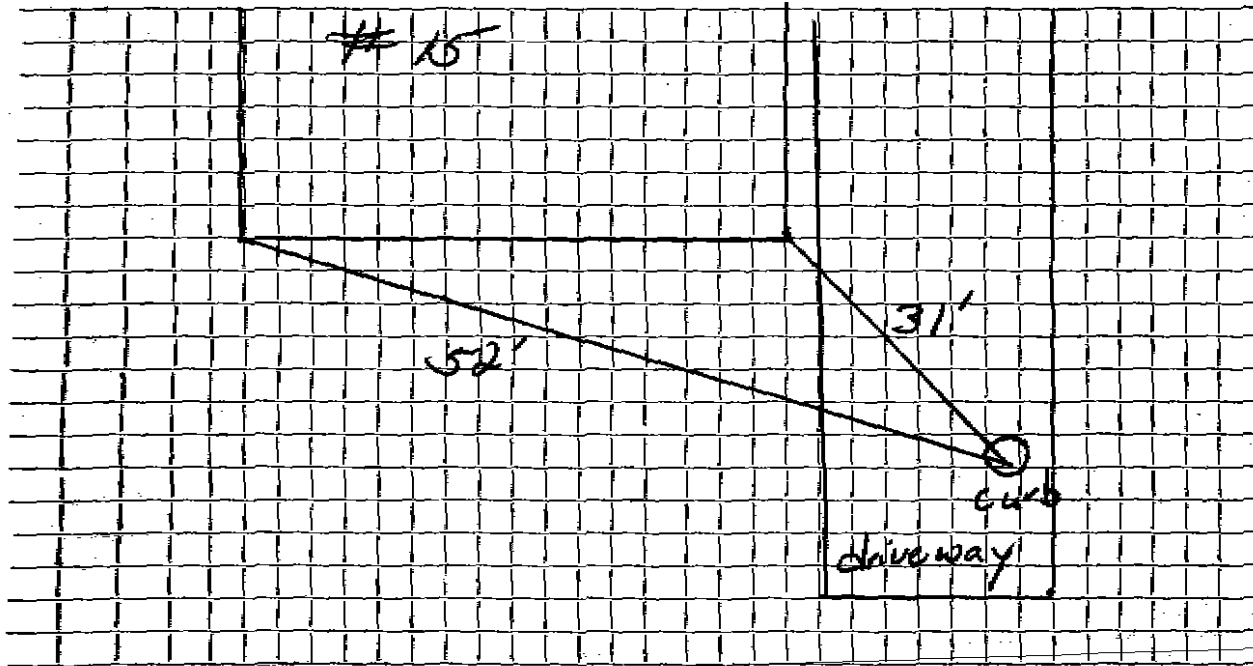

Connection made in Street. Work completed

Remarks:

.....