


DATE 9/21/92

TOWN OF LEXINGTON — BOARD OF PUBLIC WORKS
WATER DIVISION

Sketch of Service Here

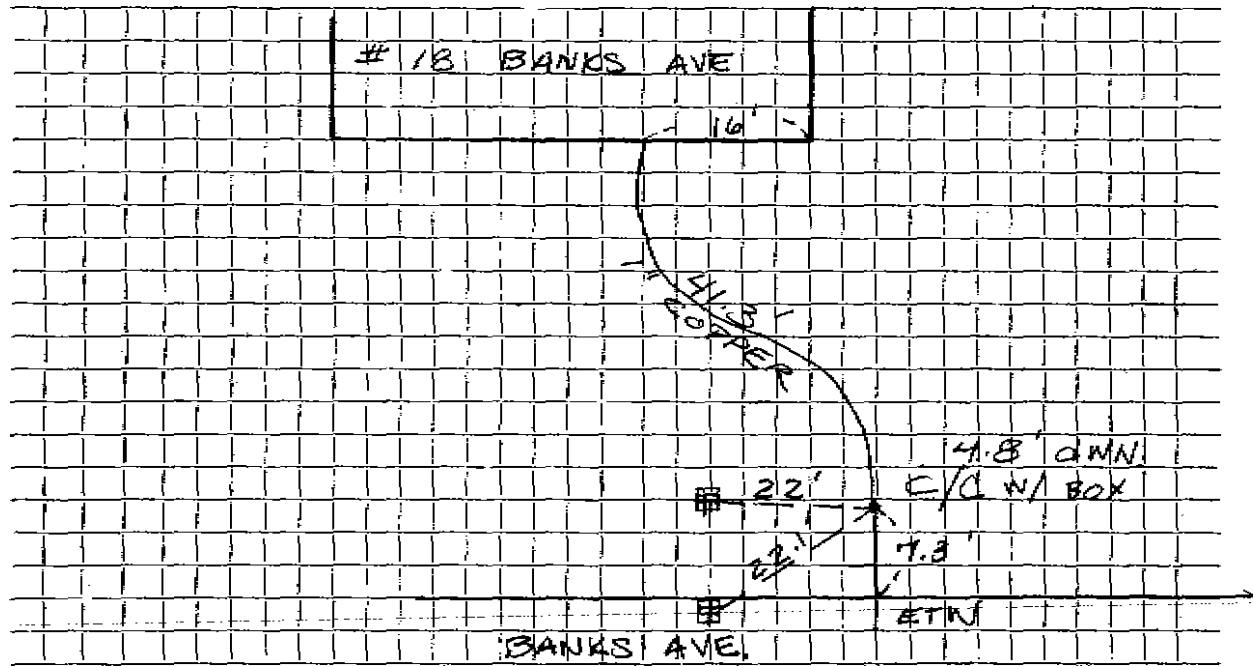

Connection made in BANKS AVE. Street. Work completed ETW BY ARLEX

Remarks:

.....

.....