

Name Walter Peterson

Service No. 101 # 5210

Address 45 Banks Avenue

Lexington, Mass.

Location 45 Banks Avenue

Kind of Pipe

Size

Size of Main

~~Repair - Renewal - New Service~~

Com. 7-3-50

Location

Date	Material	Amount	Total	Date	Amount
May 25, '50	Labor	1 30	1 30	May 17 '50	20 00
	10% Overhead		13	July 20 '50	2 75
	37' - 3/4" Copper Tubing @.23		8 51		13 98
	1 - 3/4" C x 1/2" I.W.H. S&W		3 29	May 25, '50	2 60
	Trucking 1 hr. @.75		75	11' - 3/4" Copper Tubing @.23	2 53
			13 98	1 - 3/4" C Corp-cock	3 15
				1 - 3/4" C x 3/4" C Curb-cock	3 85
				1 - Box & Rod	3 35
				1 - 1/2" Offset Tail Piece	38
				1 - 1/2" Straight Tail Piece	38
				Trucking 1 hr. @.75	75
					16 99
	Labor				

Deposited
Refunded
No Charge

DATE _____

TOWN OF LEXINGTON - BOARD OF PUBLIC WORKS

WATER DIVISION

The undersigned applies for a supply of water at No..... St. and hereby agrees to comply with the rules and regulations as now, or at any future time, established by the Board of Selectmen.

Am't of Estimate \$.....

Owner


Am't Paid \$.....

Address

Builder

.....

Sketch of Service Here

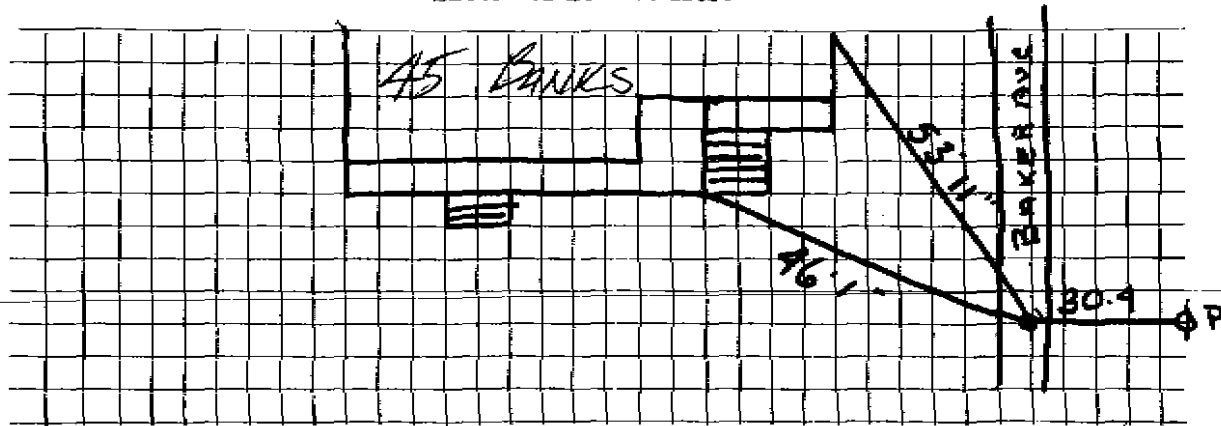

Connection made in Street.

Work completed19

Remarks: