

WATER SERVICE RECORD

Name Robert King

Service No. 125

Address @ Banks Avenue

Location

~~RENEWAL~~ - Renewal - ~~NECESSARY~~

Comm 7-6-59


Date	Material	Amount	Total	Date		Amount
6-17-59	Labor	1 85		6-17-59	Deposit	40 00
	10% O.H.	19	2 04	7-6-59	Retard	24 00
20	3/4" Copper Tubing @ 3666		7 33			16 00
1	3/4" Cx3/4" TWH Stop&Waste		5 88		NON CHARGE	
1	Hr. Trucking @.75		75	6-17-59	Labor	9 06
			16 00		Labor	40 00 40 00
					20' 3/4" Copper Tubing @ 3666	7 33
					1 3/4" C Curb Cock	6 07
					1 3/4" C Corp Cock	4 67
					1 Box & Rod	5 00
					1 3/4" Offset Tail piece	50
					1 3/4" Straight Tailpiece	50
					2 Hrs. Town Shovel @6.50	13 00
					1 Hr. Trucking @.75	75
					1 Hr. Rodgers Trailer @3.00	3 00
						89 98

DATE _____

TOWN OF LEXINGTON — BOARD OF PUBLIC WORKS

WATER DIVISION

Sketch of Service Here

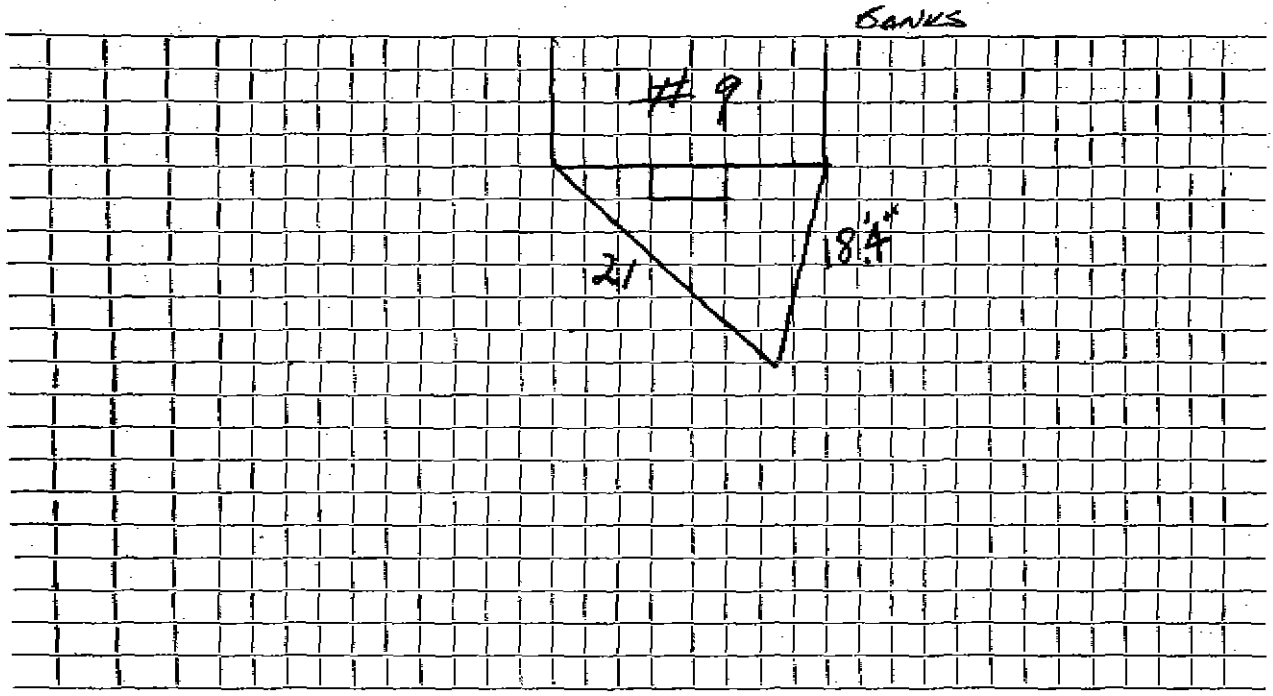

Connection made in Street. Work completed

Remarks:
.....
.....