

WATER SERVICE RECORD

Name George Foundas

Service No. 236

Address 1 Barberry Road

Location

~~Repair~~ ~~Renewal~~ New Service

Com - 3-16-59


Date	Material	Amount	Total	Date		Amount
11/25/58	Labor	27 17		11-3-58	Deposit	25 00
	10% overhead	2 72	29 89	5-4-59	Paid	11 27
	96' - 3/4" Copper tubing @ .37		35 52			86 27
	1 - 3/4" Cx 1/2 I.W.H. Stop & Waste		5 84			
	1 hr. Trucking		75		NON CHARGE	
	1 - 3/4" C. Union (3 part)		2 27	11/25/58	Labor	4 34
	12x3 Patch		12 00	15' - 3/4" Copper tubing @ .37		5 55
			86 27	1 - 3/4" C. Corp Cock		4 64
				1 - 3/4" C. Curb Cock		6 03
				1 Box & Rod		5 00
				1 - 1/2 Straight tailpiece		50
				1 - 1/2 Offset tailpiece		50
				2 hrs. Pippin Backhoe @ 4.50		9 00
						35 56
				Bill sent 3-16-59		11 27

DATE \_\_\_\_\_

TOWN OF LEXINGTON — BOARD OF PUBLIC WORKS

**WATER DIVISION**

Sketch of Service Here

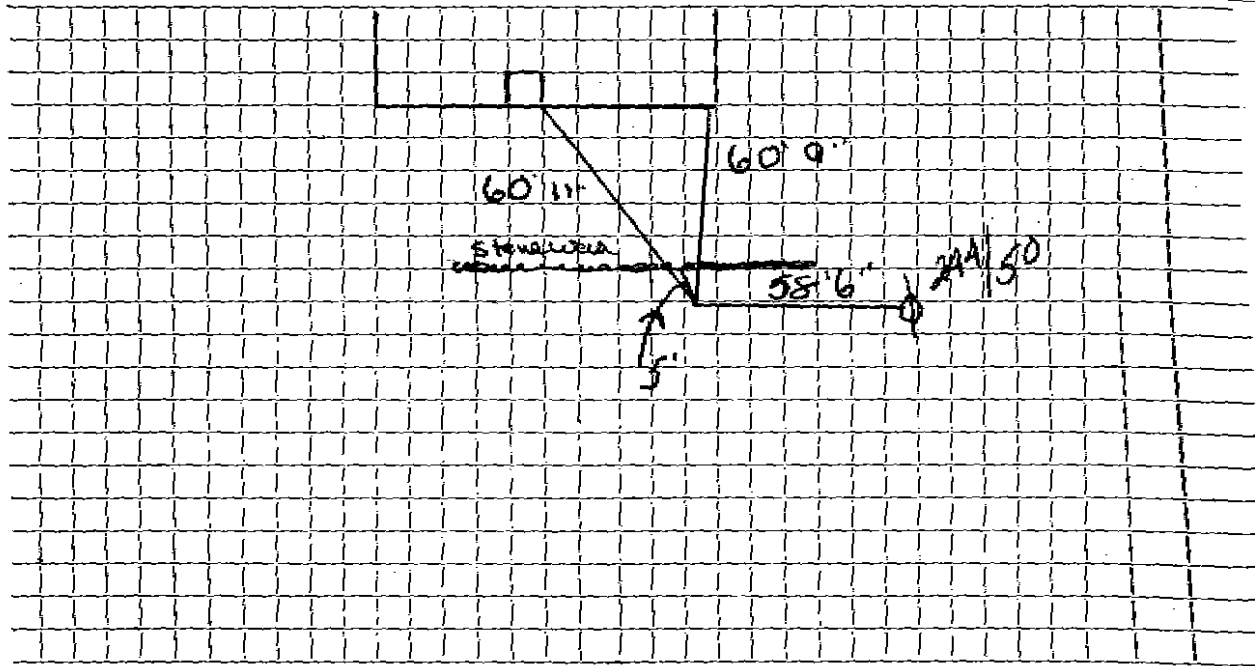

Connection made in ..... Street. Work completed .....

Remarks: .....  
.....  
.....