

WATER SERVICE RECORD

Name Moore Construction Co.

Service No. 104

Address 10 Barberry Road

Location

~~Repair~~ ~~Reconnect~~ - New Service

*Can 8-21-53*

Date	Material	Amount	Total	Date	Amount
7/31/53	Labor	12 00		5-20-53	Deposited 50 -
	10% overhead	1 20	13 20	9-2-53	Paid 1 46
	51' - 3/4" copper tubing @.3629	18 51			NON CHARGE 51 46
	1 -3/4"C x 3/4" I.W.H. stop & waste	4 00		7/31/53	Labor 13 00
	2 hrs. Littlefield shovel @ 7.50	15 00			22' - 3/4" copper tubing @.3629 7 98
	1 hr. trucking		75		1 - 3/4"C. corp-cock 4 33
			51 46		1 - 3/4"C x 3/4"C. curb-cock 4 67
					1 box and rod 3 90
					1 - 1/2 offset tail pc. 50
					1 - 1/2 straight tail pc. 50
					2 hrs. Littlefield shovel @ 7.50 15 00
					1 hr. trucking 75
					50 63

*Can 8-21-53*


DATE \_\_\_\_\_

TOWN OF LEXINGTON — BOARD OF PUBLIC WORKS

**WATER DIVISION**

Sketch of Service Here

W.S. For # 10

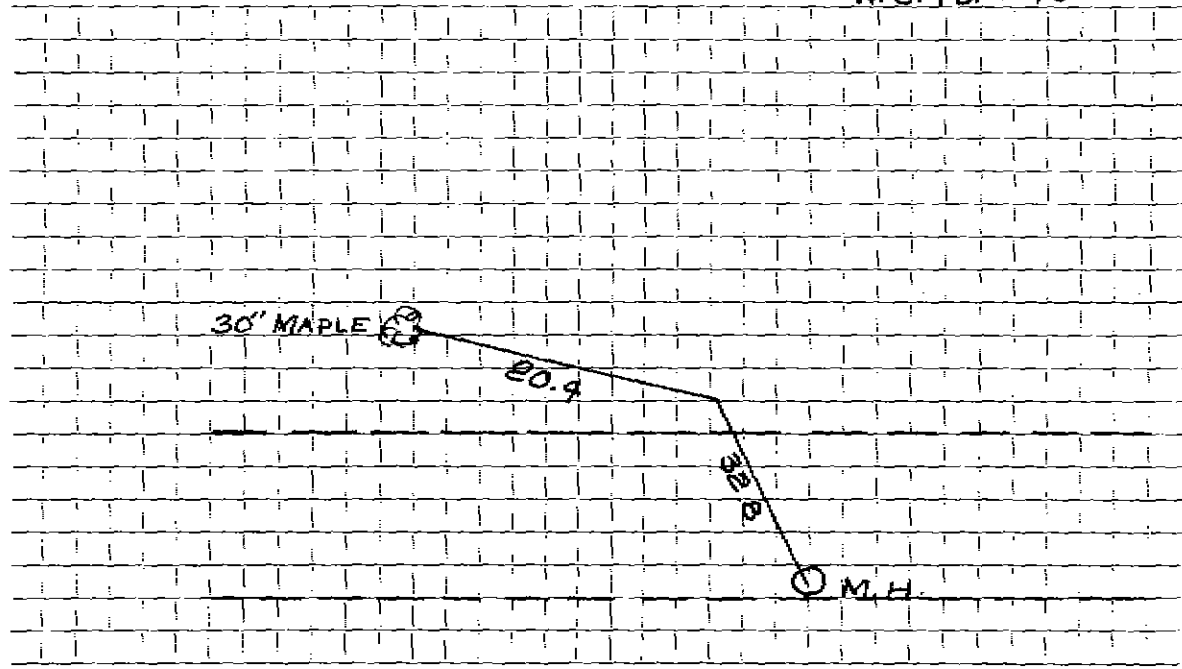

Connection made in ..... Street. Work completed .....

Remarks: .....  
.....  
.....