

WATER SERVICE RECORD

Name Robert Gray

Service No. 121

Address 11 Barberrry Rd.

Location Lexington

Repair ~~X~~ Renewal ~~X~~ New Service

AM. 7-13-53

Date	Material	Amount	Total	Date	Amount
6/5/53	Labor	7 02		6-5-53	75 00
	10% overhead	70	7 72	8-18-53	39 44
	257'-3/4" Copper Tubing @.37		95 09	SERVICE WAS IN TO CURB:	
	1-3/4" C x 1/2 I.W.F. STOP & WASTE		4 00	NON CHARGE \$114 44	
	1-3/4" C x 3/4" C. Unions(3 parts)	6 88		1-3/8" straight tail piece	50
	1 Hr. Trucking	0 75	75	1-1/8" offset tail piece	50
			114 04		1 00
	TRENCH DUG BY OWNER.				
				7/23/52	9 25
				Labor	
				10' 3/4" Copper tubing @ .326	3 26
				1 3/4" C. Corp cock	4 33
				1 3/4" C x 3/4" C. Curb cock	4 67
				1 Box & Rod	4 68
				1 Hr. trucking	75
					26 94




DATE \_\_\_\_\_

TOWN OF LEXINGTON — BOARD OF PUBLIC WORKS

**WATER DIVISION**

Sketch of Service Here

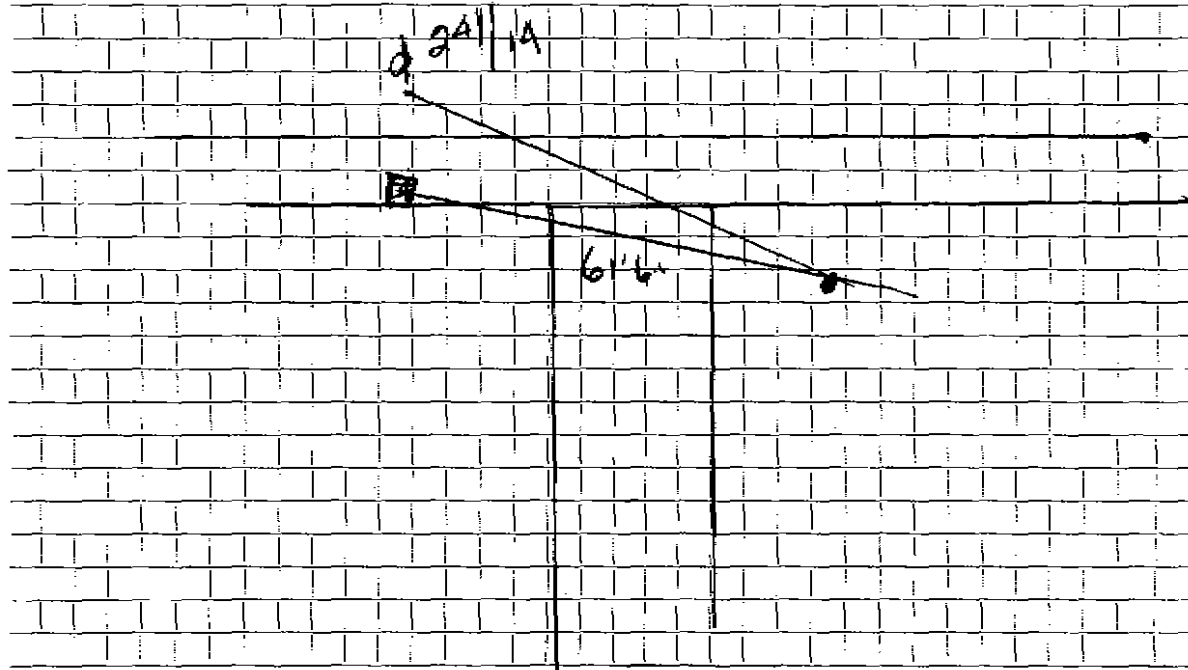

Connection made in ..... Street. Work completed .....

Remarks: .....

.....  
.....