

WATER SERVICE RECORD

3013

Name Frank Schlesinger

Service No. 122

Address 12 Barberrry Rd.

Location Lexington

Repair ~~RENEWAL~~ - New Service

Cm. 7-13-53


Date	Material	Amount	Total	Date	Amount	
6/5/53	Labor	19 00		6-4-53	30 00	
	10% overhead	1 90	20 90	8-2-54	42 52	
	95' - 3/4" Copper Tubing @ .37	35 15			92 52	
	1-3/4" C x 1/2" I.W.N. STOP WASTE	4 00			NON CHARGE	
	1-3/4" C x 3/4" C. Union (3 parts)	1 72		1-1/2" offset tail piece	50	
	4 Hr. Littlefield Shovel	7 50	30 00	1-1/2" straight tail piece	50	
	1 Hr. Trucking		75		1 00	
			92 52			
					OUTSIDE	
				7/23/52	Labor	9 25
					28' 3/4" Copper tubing @ .326	9 13
					1 3/4" C. Corp cock	4 33
					1 3/4" C. x 3/4" C. curb cock	4 67
					1 Box and rod	4 68
					1 Hr. trucking	75
					#0	
					32	81

DATE _____

TOWN OF LEXINGTON — BOARD OF PUBLIC WORKS

WATER DIVISION

Sketch of Service Here

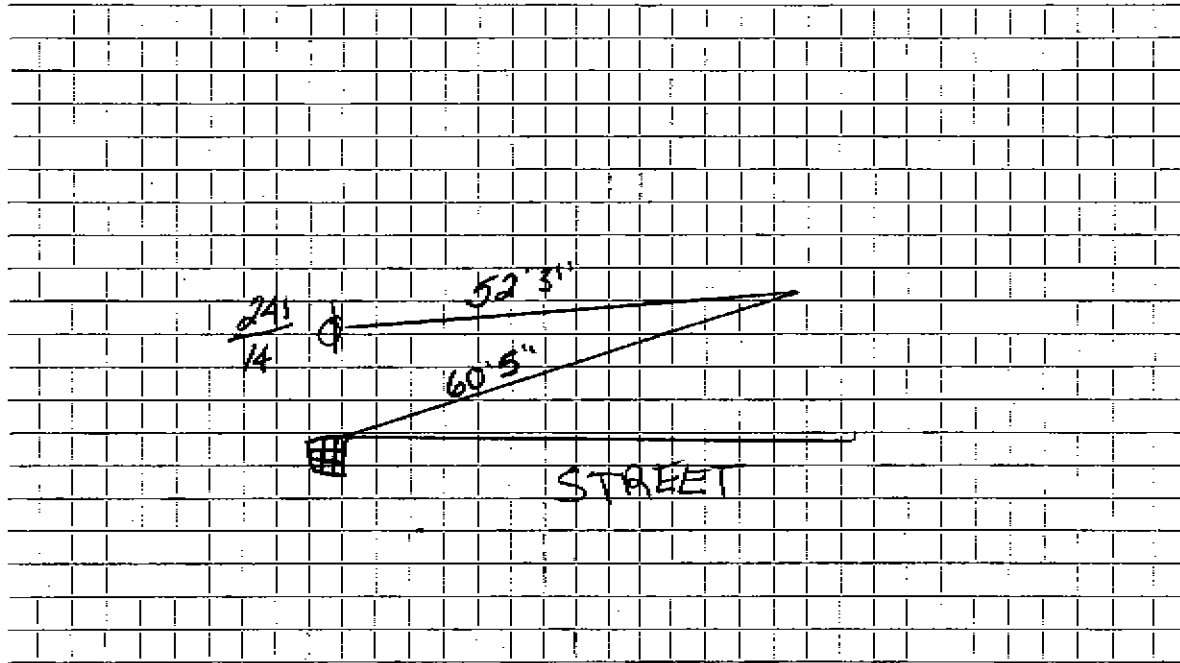

Connection made in Street. Work completed

Remarks:

.....

.....