

WATER SERVICE RECORD

Name Moore Construction Co.

Service No. 160

Address 13 Barbary Road

Location

~~XXXXXXXXXX~~ - New Service

Am 7-13-53


Date	Material	Amount	Total	Date	Amount
6/24/53	Labor	19 00		6-17-53	Deposited 100 00
	10% overhead	1 90	20 90	7-13-53	Refunded 15 96
	97' - 3/4" copper tubing @ .37		35 89		<u>NON CHARGE</u> 84 04
	1 - 3/4" Cx 1/2 I.W.H. stop & waste	4 00			SERVICE WAS IN TO CURB:
	3 hrs. Littlefield shovel @ 7.50	22 50	22 50	1 - 1/2 offset tail piece	50
	1 hr. trucking		75	1 - 1/2 straight tail piece	50
			84 04		1 00

DATE _____

TOWN OF LEXINGTON — BOARD OF PUBLIC WORKS

WATER DIVISION

Sketch of Service Here

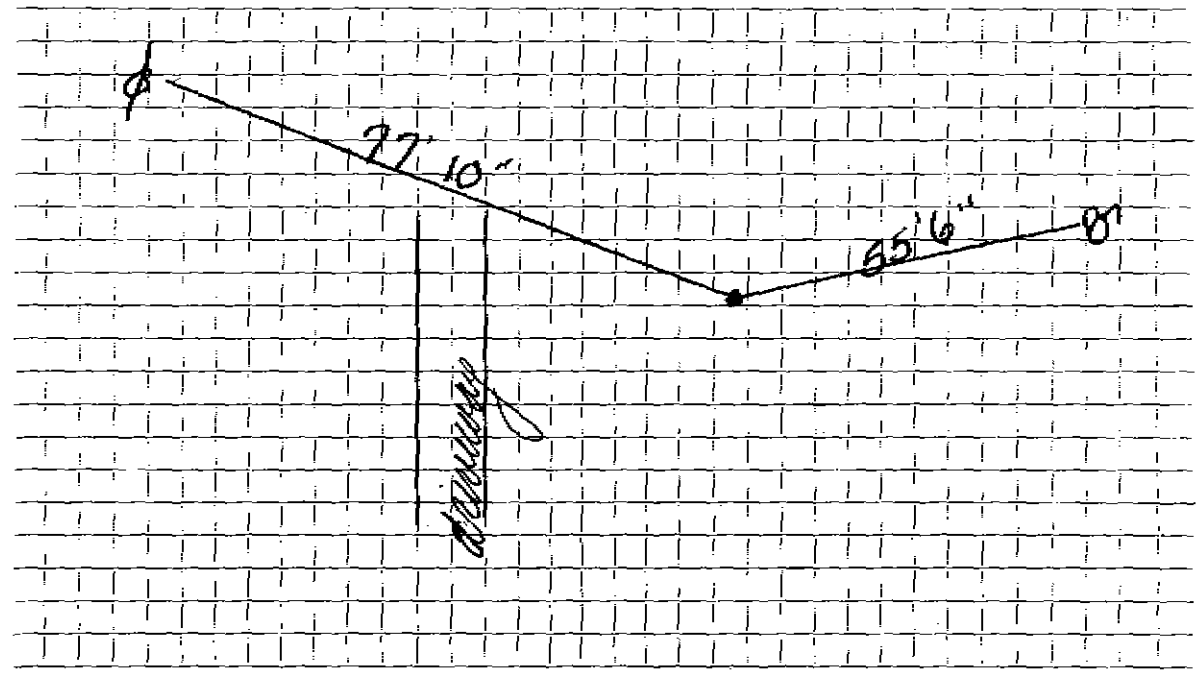

Connection made in Street. Work completed

Remarks:
.....
.....