

WATER SERVICE RECORD

Name Moore-Construction Company

Service No. 218

Address 14 Barberry Road,

Location Lexington, Mass.

Com. 11-3-52

~~Repair/Replacement~~ New Service

SERVICE WAS IN TO CURB


Date	Material	Amount	Total	Date	Amount
10/1/52	Labor	1 63		9-15-52	Deposited 70 00
	10% Overhead	16	1 79	11-5-52	Refunded (27) 74
	100' - 3/4" Copper tubing @ .34	34 00			NON CHARGE 42 26
	1 - 3/4" C x 1/2" I.W.H. stop & waste	4 00		1 - 1/2"	offset tail piece 50
	1 - 3/4" C x 3/4" C. Union	3 pts. 1 72		1 - 1/2"	straight tail piece 50
	1 hr. trucking		75		1 00
			42 26		
					OUTSIDE
				1/23/52	Labor 9 25
	TRENCH DUG BY OWNER			28'	3/4" Copper tubing @ .326 9 13
				1	3/4" C. Corp cock 4 33
				1	3/4" C x 3/4" C. Curb cock 4 67
				1	Box and rod 4 68
				1 hr,	trucking 75
					32 81

DATE _____

TOWN OF LEXINGTON — BOARD OF PUBLIC WORKS

WATER DIVISION

Sketch of Service Here

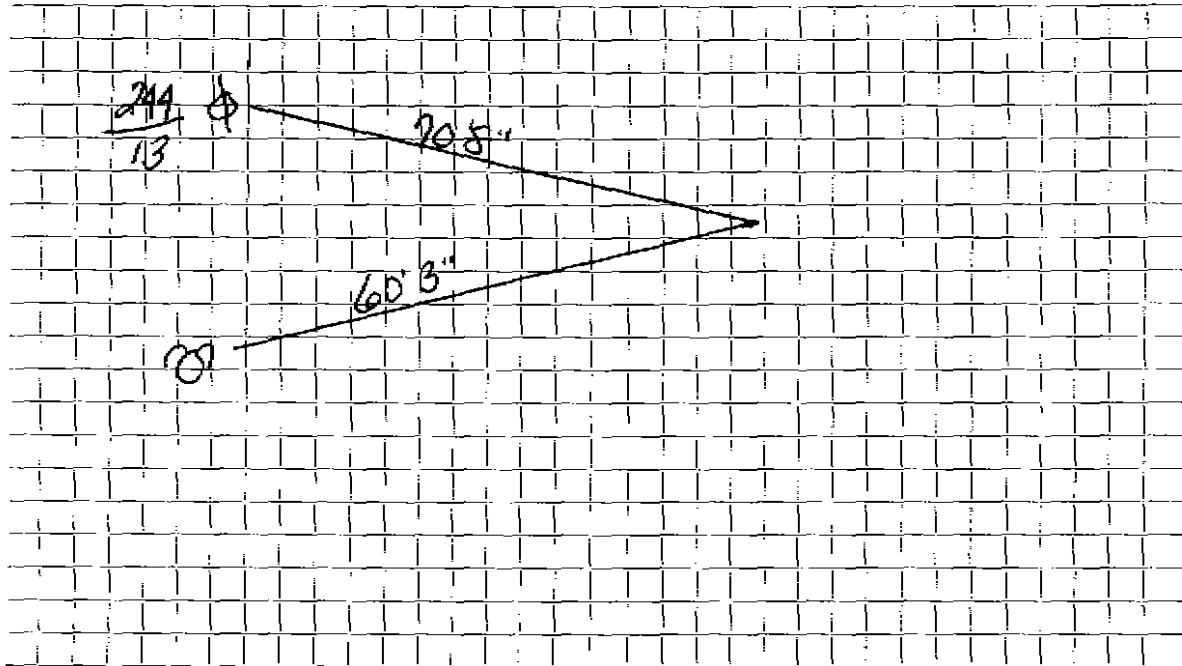

Connection made in Street. Work completed

Remarks:

.....

.....