

WATER SERVICE RECORD

Name Deck House Inc.

Service No. 141

Address 15 Barberrry Road

Location Lexington

~~Repair~~ ~~XXXXXX~~ New Service ~~W6#~~ 8370

MAR 23 1964


Date	Material	Amount	Total	Date	Amount
12-17-63	Labor	9.86		11-22-63	200.00
	10% O.H.	.99	10.85	3-23-64	135.57
	100' 3/4" Copper Tubing @.42		42.00	7/23/52	64.43
	1 3/4" CX 1/2 I.W.H. Stop & Waste	6.17			9.25
	1 3/4" C3 Part Union	2.41		10' - 3/4" Copper tubing @.326	3.26
	1 Hr. Trucking @3.00	3.00		1 - 3/4" C. Corp cock	4.33
			64.43	1 - 3/4" C x 3/4" C. curb-cock	4.67
				1 box and rod	4.68
				1 hr. trucking	75
					26.94
				12-17-63 1 1/2 Straight Tailpiece	50
				1 1/2 Offset Tailpiece	50
					27.94

DATE _____

TOWN OF LEXINGTON — BOARD OF PUBLIC WORKS

WATER DIVISION

Sketch of Service Here

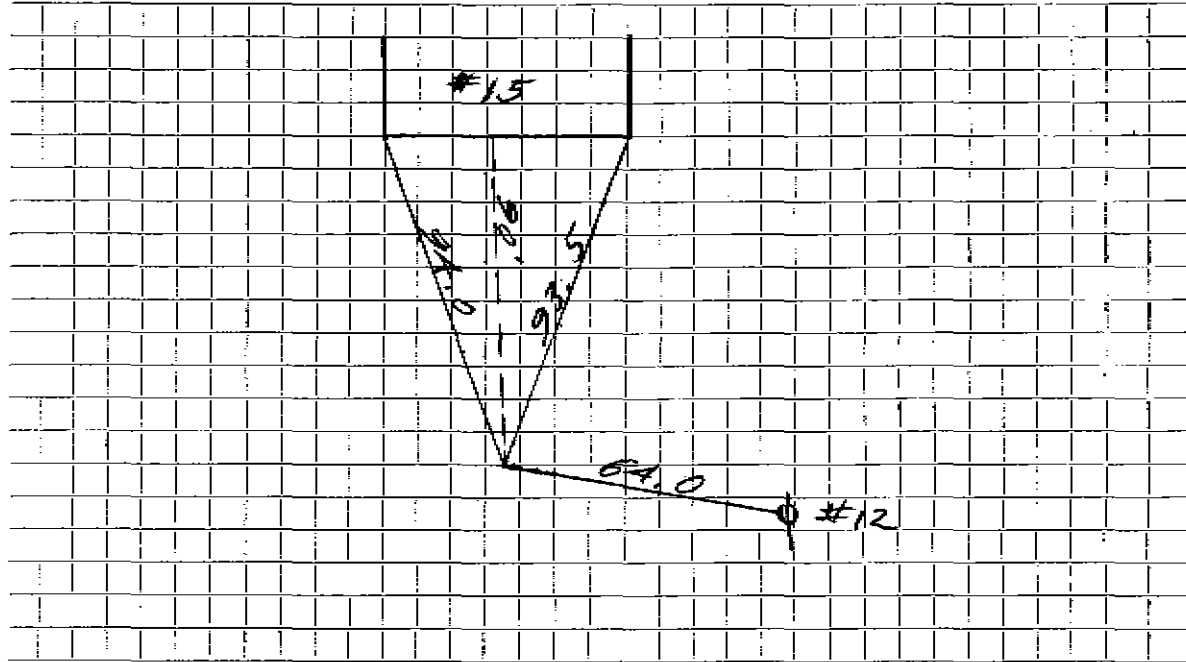

Connection made in Street. Work completed

Remarks:

.....

.....