

WATER SERVICE RECORD

Name Site & Shelter

Service No. 155

Address 16 BARBERRY ROAD

4674

Location Lexington

~~Repair & Renewal~~ - New Service COM. 9/8/52


Date	Material	Amount	Total	Date	Amount
7/23/52	Labor	1 63		7-23-52	40 00
	10% overhead	16	1 79	9-10-52	33 46
	1 - 3/4" C x 1/2" D.W.H. stop & waste	4 00		<i>Deposited</i> <i>Refunded & credited</i> <i>Total due on #252</i> <u>NON CHARGE (252)</u>	
	1 - hr. trucking		75	7/23/52	7 62
			6 54	28' - 3/4" copper tubing @ .326	9 13
	TRENCH DUG BY OWNER			1 - 3/4" C. corp-cock	4 33
	PIPE SUPPLIED AND LAID BY OWNER			1 - 3/4" C x 3/4" C. curb-cock	4 67
				1 - box and rod	4 68
				1 - 1/2" 1/2" offset tail piece	50
				1 - 1/2" straight tail piece	50
				1 - hr. trucking	75
					<u>32 18</u>

DATE _____

TOWN OF LEXINGTON — BOARD OF PUBLIC WORKS

WATER DIVISION

Sketch of Service Here

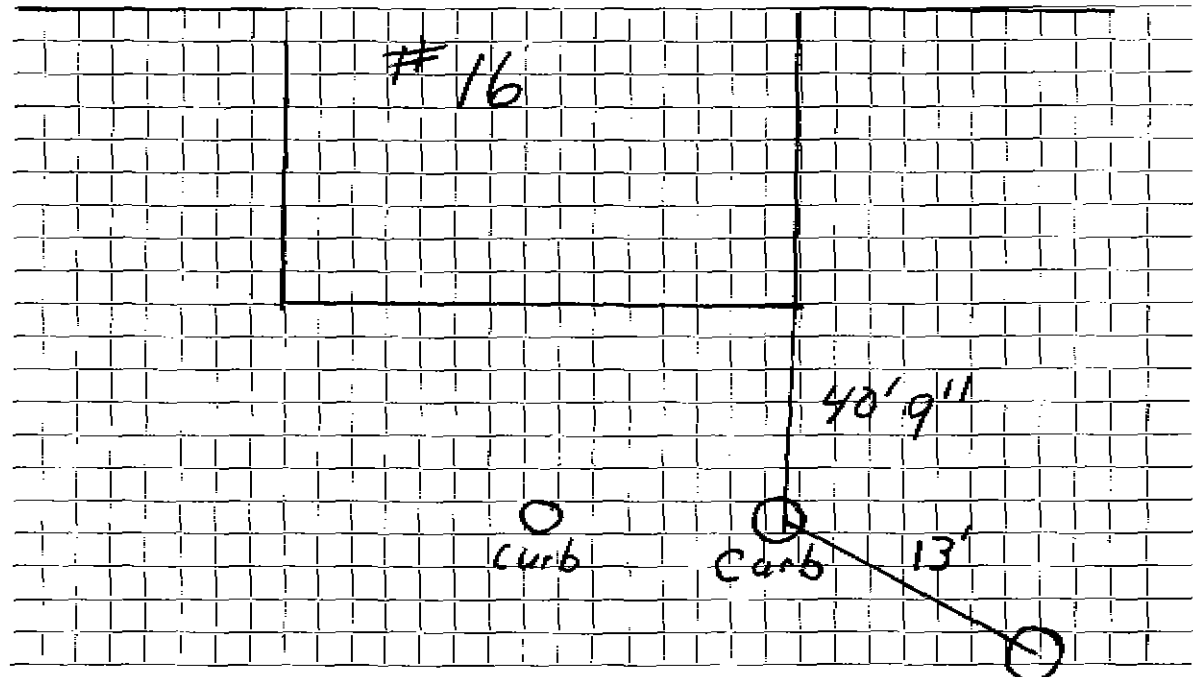

Connection made in Street.

Work completed S.M.H.

Remarks:
.....
.....