

WATER SERVICE RECORD

Name Stanley Phelan

Service No. 252

Address 17 Barberry Road

Location

~~REPAIRS~~ New Service


Comm. 12-2-57

Date	Material	Amount	Total	Date	Amount
10/30/57	labor	19 04		10-29-57	Deposit \$ 150 10
	10% overhead	1 90		12-2-57	Refund \$ 72 43
			20 94		\$ 77 57
	97' 3/4" copper tubing @.375		36 38		NON CHARGE
	1 3/4" Cx 1/2 IWH stop & waste		4 96		labor 2 65
	1 hr. trucking @.85		75		15' 3/4" copper tubing .375 5 63
	2 3/4" C 3 part Union @2.27		4 54		1 3/4" C corp cock 4 64
	10 x 3 patch		10 00		1 3/4" C curb cock 5 94
			77 57		1 box & rod 4 62
					1 1/2 straight tail pc. 50
					1 1/2 offset tail pc 50
					24 48

DATE _____

TOWN OF LEXINGTON — BOARD OF PUBLIC WORKS
WATER DIVISION

Sketch of Service Here

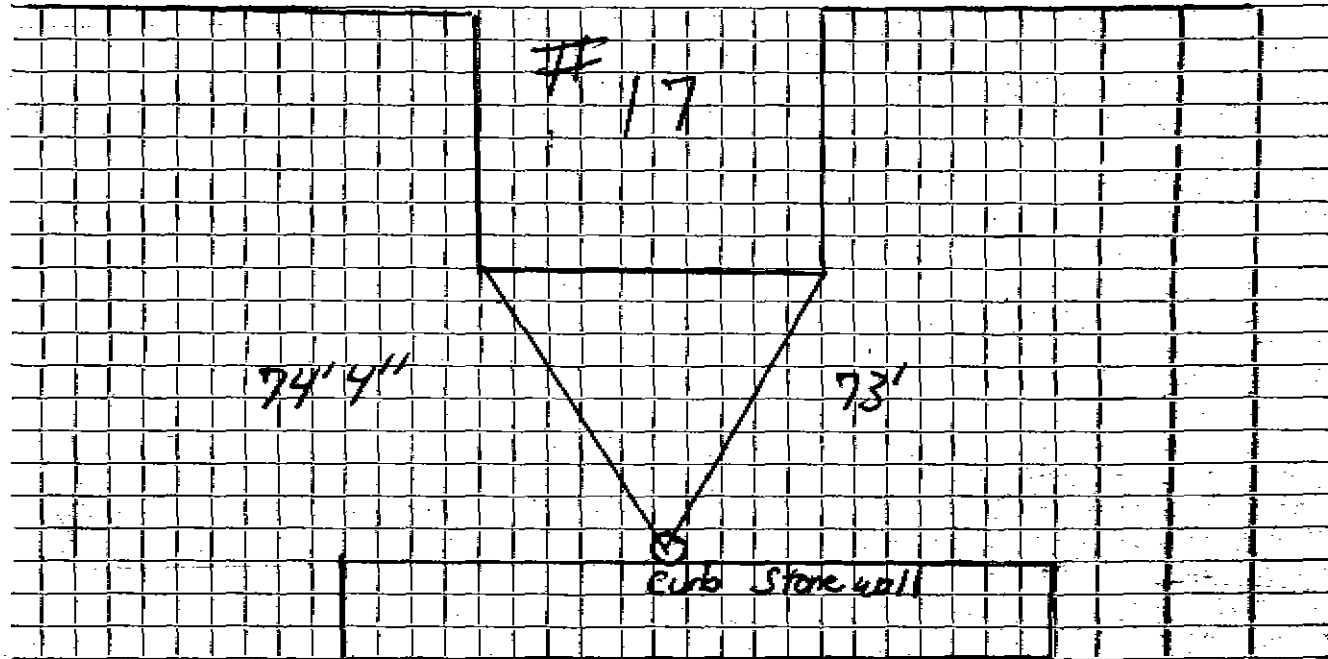

Connection made in Street. Work completed

Remarks:

.....

.....