

WATER SERVICE RECORD

Name Site & Shelter

Service No. 156

Address 18 Barbary Road

Location Lexington

~~XXXXXXXXXXXX~~ - New Service COM. 9/8/52


Date	Material	Amount	Total	Date	Amount
7/23/52	Labor	1 63		7-25-52	Deposited 40 00
	10% overhead	16	1 79	9-10-52	Refunded & credited (13 90)
	60' - 3/4" copper tubing @ .326		19 56		10/20/52. doc on #232 NON CHARGE (1951) 26 10
	1 - 3/4" C. x 1/2" I.W.H. stop & waste		4 00	7/23/52	Labor 7 62
	1 hr. trucking		75		28' - 3/4" copper tubing @ .326 9 13
			26 10		1 - 3/4" C. corp-cock 4 33
	TRENCH DUG BY OWNER				1 - 3/4" C x 3/4" C. curb-cock 4 67
					1 - box and rod 4 68
					1 - 1/2" offset tail piece 50
					1 - 1/2" straight tail piece 50
					1 hr. trucking 75
					<u>32 18</u>

DATE _____

TOWN OF LEXINGTON — BOARD OF PUBLIC WORKS

WATER DIVISION

Sketch of Service Here

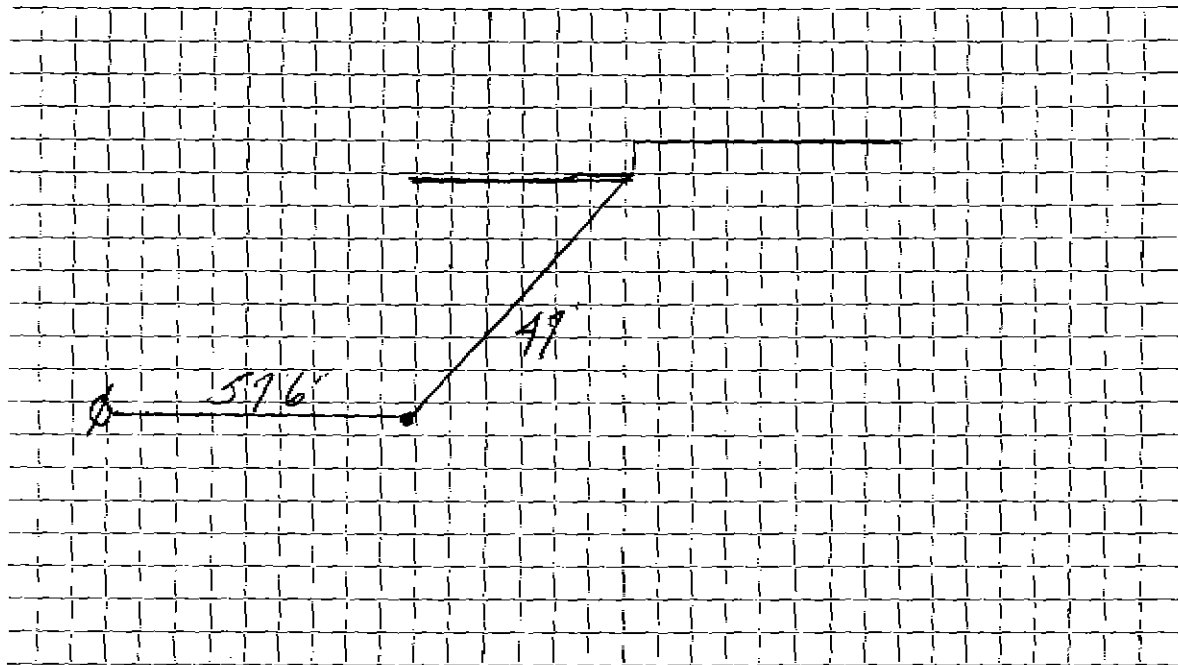

Connection made in _____ Street. Work completed _____

Remarks: _____
