

WATER SERVICE RECORD

Name _____

Service No.

Address

2 Barberry AD

Location


Repair—Renewal—New Service DEM 1-02

DATE _____

TOWN OF LEXINGTON — BOARD OF PUBLIC WORKS

WATER DIVISION

Sketch of Service Here

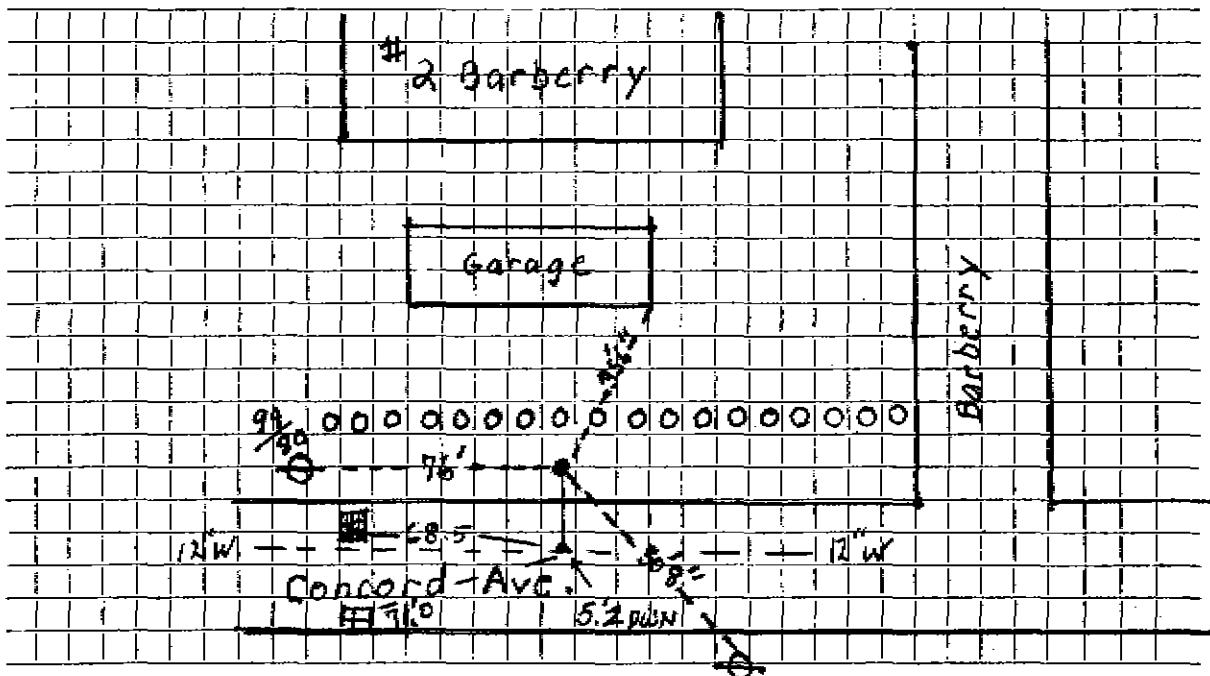

Connection made in Street. Work completed Aug. 2002

Remarks: 15' 0" MAIN To Curb., 12" WATER, 9' off Edge RD.