

WATER SERVICE RECORD

Service No. 375

Name Site & Shelter Co.

Address 21 Barberrry Road

Location

Repair - REMOVAL - New Service

Am. 12-21-53

Date	Material	Amount	Total	Date	Amount
11/18/53	Labor	3 50		11-17-53	
	10% overhead	35	3 85	12-21-53	
	21 51 - 1" copper tubing @ .4502	96 79			
	1 - 1" x 1" I.W.H. stop waste	4 50			
	3 - 1" x 1" unions @ .26	6 78			
	1 hr. trucking	75			
	2 - 1" x 1" copper tubing @ .4502	9 00			
	1 - 1" c. corp-cock	5 51			
	1 box and rod	3 90			
	1 pit cover and frame	9 88			
	2 - 1" straight tall piece @ .93	1 86			
	4 hrs. Littlefield shovel @ 7.50	30 00			
	1 hr. trucking	75			
			119 67		96 05

NON CHARGE

Deposited


119 67
5 33
135 00

DATE _____

TOWN OF LEXINGTON — BOARD OF PUBLIC WORKS

WATER DIVISION

Sketch of Service Here

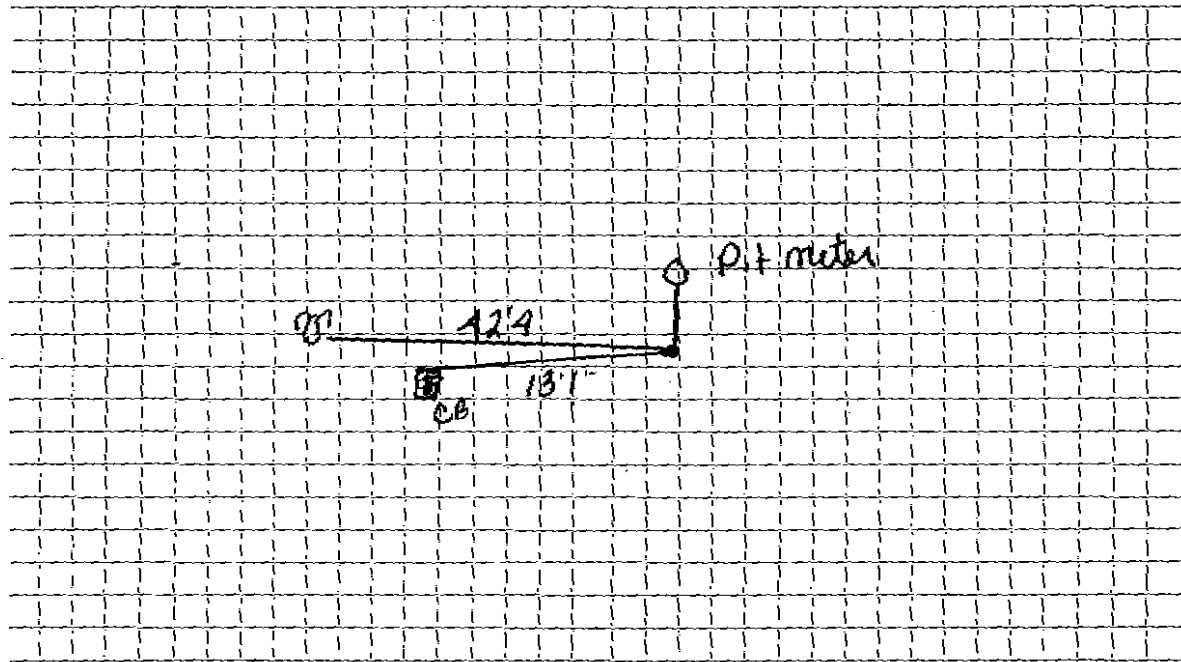

Connection made in Street. Work completed

Remarks:

.....

.....