

Name Site & Shelter, Inc.

Service No. 234

Address 22 Barberray Road

Lexington

Location

Kind of Pipe

Size

Size of Main

~~Water - Renewal~~ <sup>XXX</sup> ~~Water - Renewal~~ - New Service

*Conn. 12-0-51*

Location

Date	Material	Amount	Total	Date	Amount
10/31/51	Labor	1 65	1 65	<i>9-25-51</i>	<i>Deposited</i> 10 00
	10% overhead		17	<i>9-23-52</i>	<i>Paid</i> <u>89</u>
	8' - 3/4" copper tubing @ .326	2 60			NON CHARGE 10 59
	1 - 3/4" C x 1/2" I.W.H. stop & Waste	4 00	10/31/51	Labor	2 74
	1 - 3/4" C x 3/4" Union (3pts.)	1 72		24' - 3/4" copper tubing @ .326	7 82
	1 hr. trucking	75		1 - 3/4" C. corp-cock	4 33
			10 89	1 - 3/4" C x 3/4" C. curb-cock	4 67
	TRENCH DUG BY OWNER			1 box and rod	4 68
	PIPE SUPPLIED AND LAID BY OWNER			1 - 1/2" offset tail piece	50
				1 - 1/2" straight tail piece	50
				1 hr. trucking	75
	Labor				<hr/> 25 99

*bill sent 12-3-51*

DATE \_\_\_\_\_

# TOWN OF LEXINGTON—BOARD OF PUBLIC WORKS

## WATER DIVISION

The undersigned applies for a supply of water at No. \_\_\_\_\_ St. and hereby agrees to comply with the rules and regulations as now, or at any future time, established by the Board of Selectmen.

Am't. of Estimate \$ \_\_\_\_\_


Owner \_\_\_\_\_

Am't. Paid \$ \_\_\_\_\_

Address \_\_\_\_\_

Builder \_\_\_\_\_

Sketch of Service Here

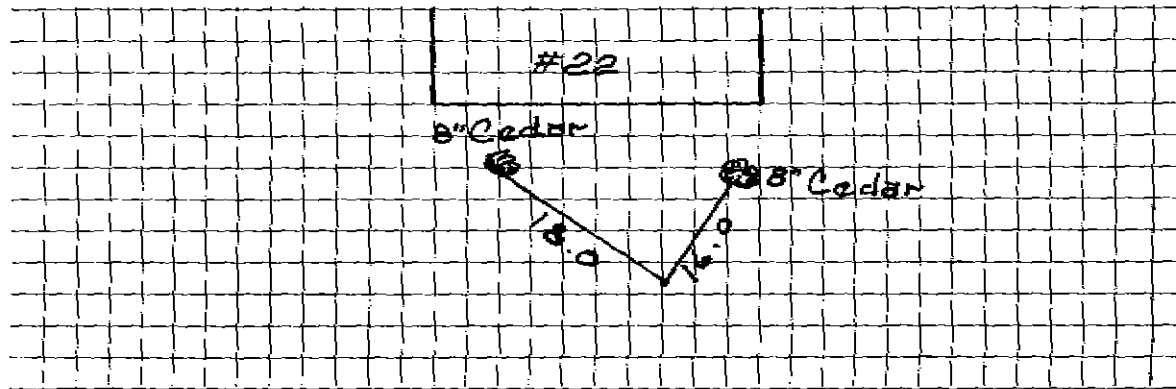

Connection made in \_\_\_\_\_ Street.

Work completed \_\_\_\_\_ 19

Remarks: