

WATER SERVICE RECORD

#1119

Name Site & Shelter, Inc.

Service No. 304

Address 31 Barberry Road

Location Lexington, Mass.

~~Repair~~ ~~Renewal~~ New Service

Len. 12-3-51

Date	Material	Amount	Total	Date	Amount
11/2/51	Labor	1 65	1 65		
	10% overhead		17		
	14' -3/4" copper tubing @ .326	4 56			
	1 -3/4" Cx 1/2" I.W.H. stop & waste	4 00			
	1 -3/4" cx 3/4" C.Union (3pt)	1 72			
	1 hr. trucking		75		
			12 85		
	TRENCH DUG BY OWNER				
	PIPE SUPPLIED AND LAID BY OWNER				
				11/2/51	Labor
					2 39
				9-23-52	9' -3/4" copper tubing @ .326
					2 93
					1 -3/4" C. Corp-cock
					4 33
					1 -3/4" Cx 3/4" C.curb-cock
					4 67
					1 - box and rod
					4 68
					1 -1/2" offset tail piece
					50
					1 -1/2" straight tail piece
					50
					1 hr. trucking
					75
					<u>20 75</u>

no Deposit

Paid


NON CHARGE

bill sent 12-3-51

DATE _____

TOWN OF LEXINGTON — BOARD OF PUBLIC WORKS
WATER DIVISION

Sketch of Service Here

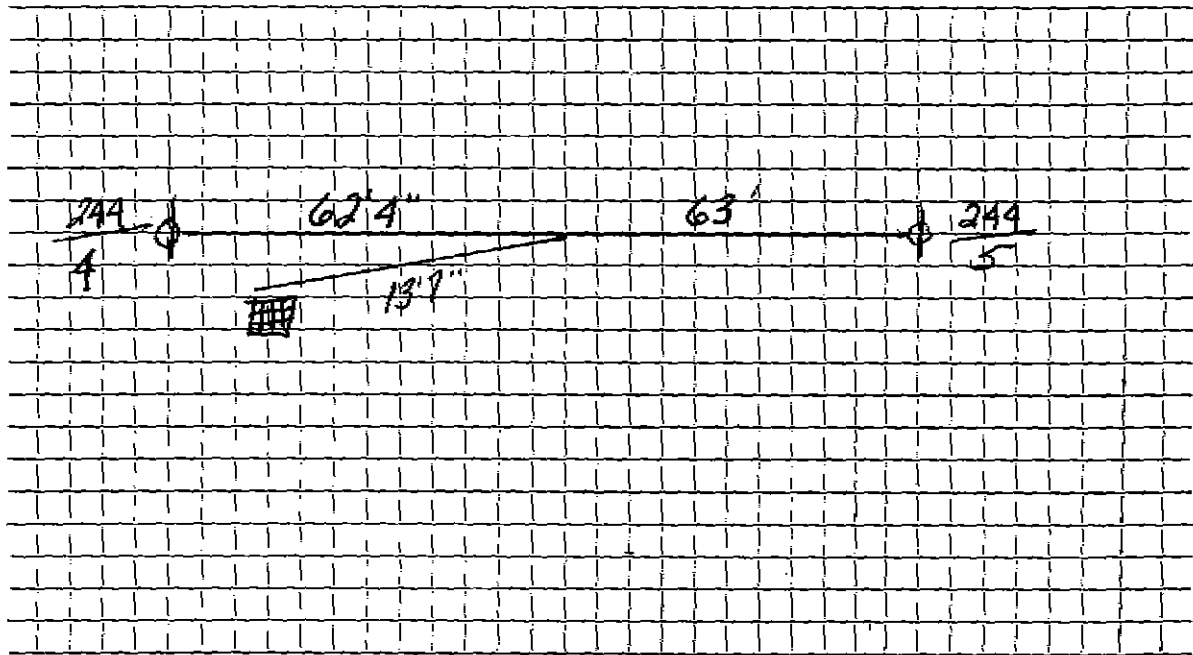

Connection made in Street. Work completed

Remarks:
.....
.....