

WATER SERVICE RECORD

Name Site & Shelter Inc.

Service No. 305

Address 33 Barberry Road

3314

Location Lexington, Mass.

Remarks ~~Renewal~~ - New Service

Com 12-3-51


Date	Material	Amount	Total	Date	Amount
11/2/51	Labor	1 65	1 65		
	10% overhead		17	9-23-52	6 57
	1 -3/4" Cx1/2 I.W.H. stop & waste	4 00			
	1 hr. trucking		75		
			6 57		
	TRENCH DIG BY OWNER			11/2/51	Labor 2 39
	PIPE SUPPLIED AND LAID BY OWNER			9' -3/4" copper tubing @ .326	2 93
				1 - 3/4" C. corp-cock	4 33
				1 - 3/4" Cx3/4" C. curb-cock	4 67
				1 box and rod	4 68
				1 -1/2 offset tail piece	50
				1 -1/2 straight tail piece	50
				1 hr. trucking	75
					20 75
				bill sent 12-3-51	

DATE _____

TOWN OF LEXINGTON — BOARD OF PUBLIC WORKS
WATER DIVISION

Sketch of Service Here

W.S. Form # 33

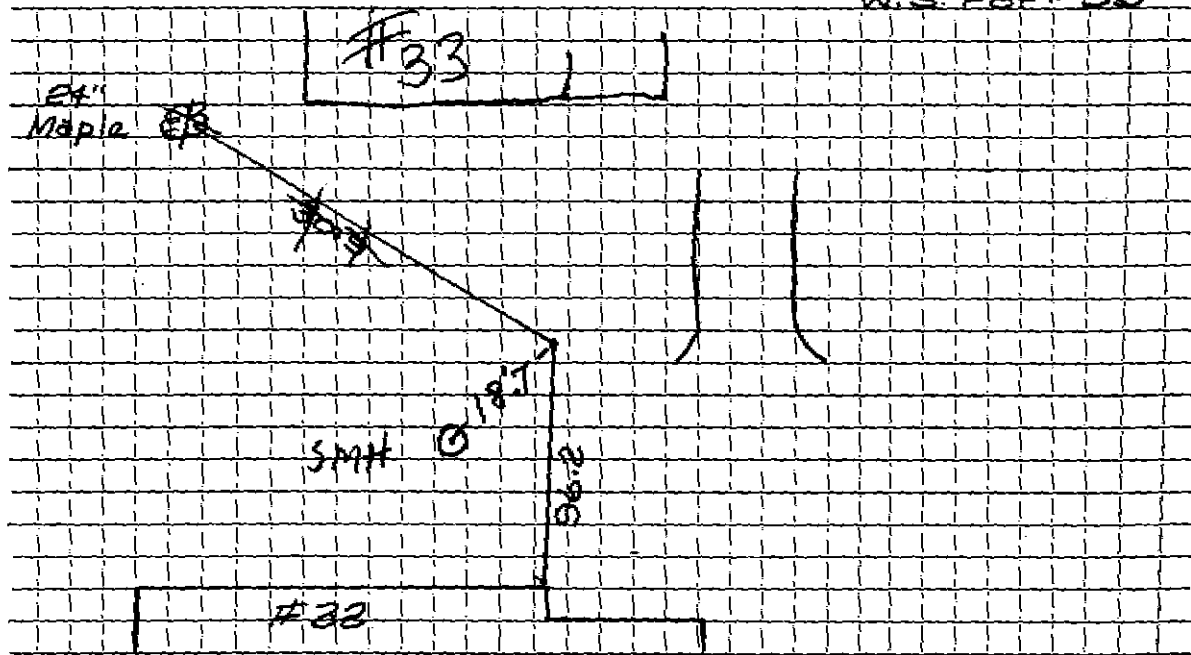

Connection made in Street. Work completed

Remarks:
.....
.....