


DATE _____

TOWN OF LEXINGTON — BOARD OF PUBLIC WORKS
WATER DIVISION

Sketch of Service Here

W.S. For # 35

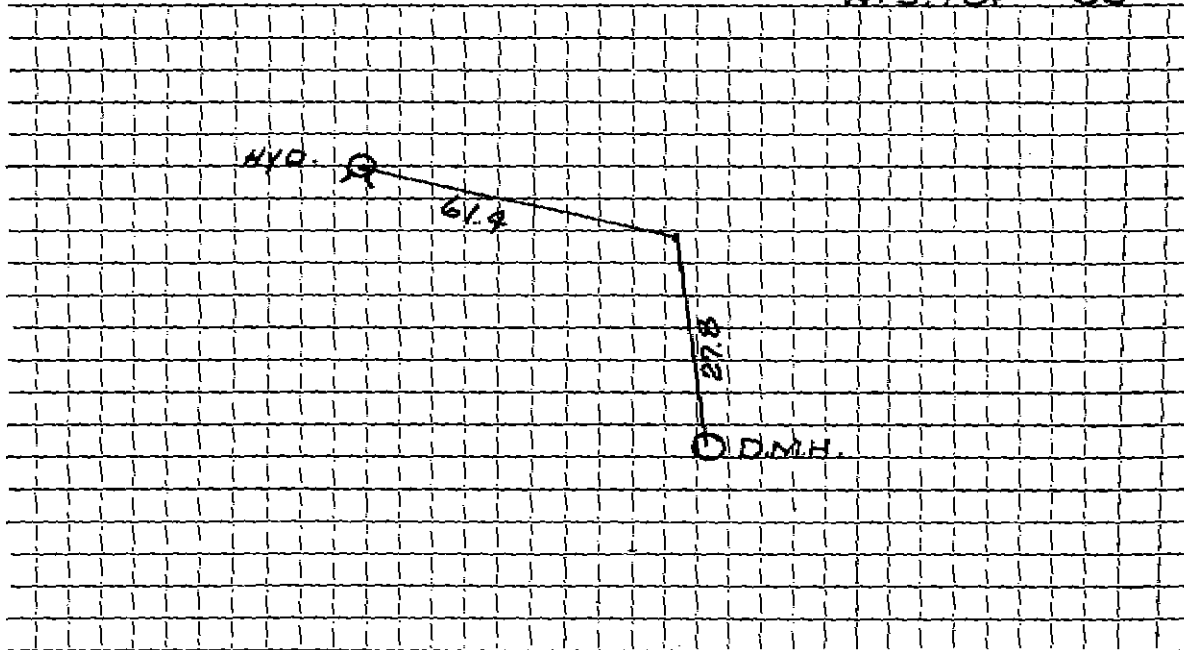

Connection made in Street. Work completed

Remarks:

.....

.....