

WATER SERVICE RECORD

Name Louis Tropeano

Service No. 289

Address 4 Barberrry Rd. 107 #17

Location

Repair ~~Renewal~~ New Service SERVICE IN TO CURB


Comm. 3-3-58

Date	Material	Amount	Total	Date	Amount
12/20/57	Labor	33 08		12-13-57	100 00
12/28/57	"	6 12		3-3-58	2 59
		39 20			<u>97 41</u>
	10% overnead	3 92		8/7/53	9 52
			43 12	19' - 3/4" Copper tubing @ .3629	6 90
	88' 3/4" copper tubing @ .37	32 56		1 - 3/4" C. corp-cock	4 33
	1 3/4" Cx 1/2 IWH stop & waste	4 96		1 - 3/4" C x 3/4" C. curb-sock	4 67
	2 hrs. trucking @ .75	1 50		1 box and rod	3 90
	1 3/4" Cunion 3 part	2 27		1 hr. truck ing	75
	2 hrs. town shovel @ 6.50	13 00		1 1/2 offset tail piece	<u>30 07</u>
	3/4 copper on outside of curb	97 41		1 1/2 straight tail piece	50
					<u>31 07</u>

DATE _____

TOWN OF LEXINGTON — BOARD OF PUBLIC WORKS
WATER DIVISION

Sketch of Service Here

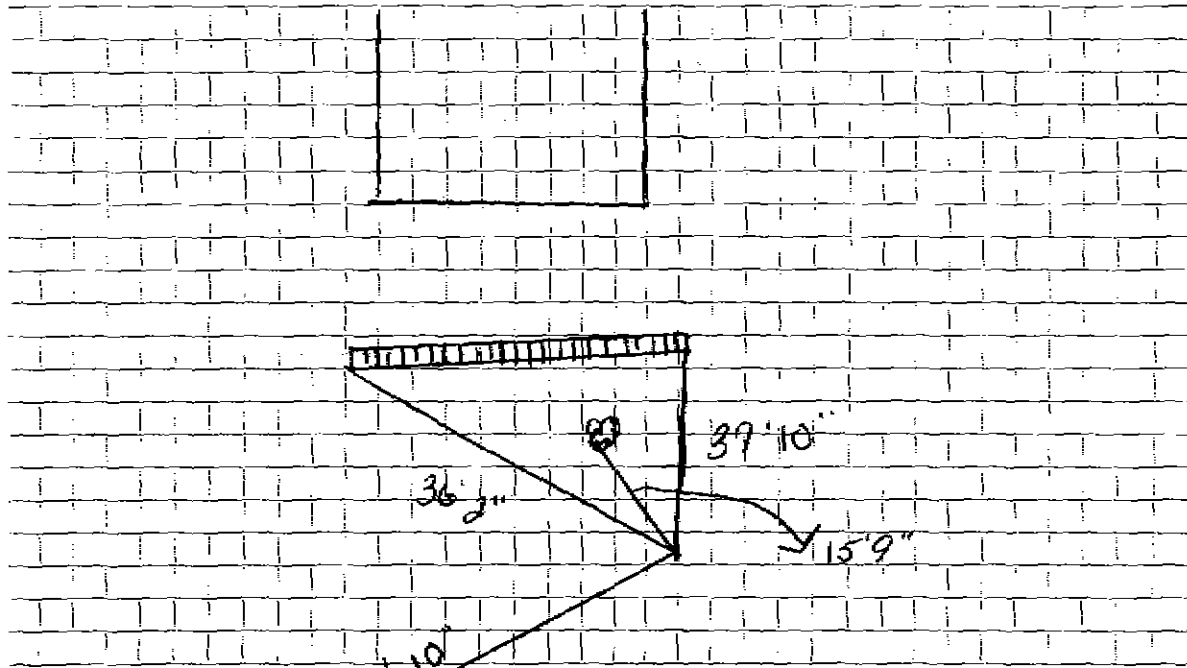

Connection made in Street. Work completed

Remarks:

.....

.....

244
—
48