

## WATER SERVICE RECORD

3240

Service No. 345 (1956)

Name Stanley Phalen

Address 5 Barbary Road

Location

~~Repairs~~ ~~Remarks~~ - New Service

Comm. 3/18/57


Date	Material	Amount	Total	Date	Amount
12-11-56	Labor	18. 57		11-9-56	Deposit \$ 75.00
	10% O.H.	1. 86	20.43	4/16/57	Paid
	105' 3/4" Copper Tubing @ .4396		46.16		
	1 3/4" C x 1/2 I.W.H. Stop & Waste		4.96		NON CHARGE
	1 3/4" C Union 3 part		2. 27	12-11-56	Labor 5.70
	1/4 hrs. Littlefield @ 8.50		34.00		11' 3/4" Copper Tubing @ .4396 4.84
	1 hr. Trucking @ .75		.75		1 3/4" C Corp Cock 4.64
			108.57		1 3/4" C Curb Cock 5.94
					1 Box & Rod 4.62
					2/3 hr. Littlefield @ 8.50 5.66
					1 hr. Trucking @ .75 .75
					1 1/2 Straight tailpiece .50
					1 1/2 Offset tailpiece .50
					33.15
					Bill sent 3/19/57

DATE \_\_\_\_\_

TOWN OF LEXINGTON — BOARD OF PUBLIC WORKS

**WATER DIVISION**

Sketch of Service Here

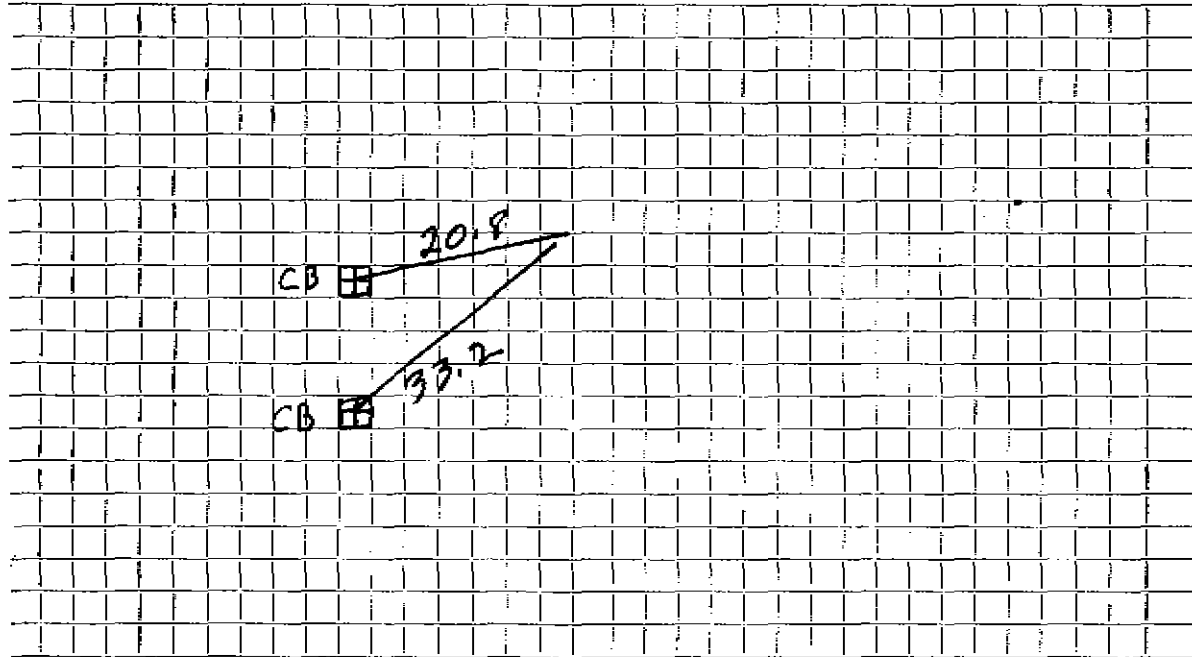

Connection made in ..... Street. Work completed .....

Remarks: .....

.....

.....