

#4983

WATER SERVICE RECORD

Name Peter Crowley

Service No. 80

Address 6 Barrymore St. Apt #18

Location

Expedited Renewal - New Service


SERVICE IN TO CURB

Comm. 7/22/57

DATE _____

TOWN OF LEXINGTON — BOARD OF PUBLIC WORKS
WATER DIVISION

Sketch of Service Here

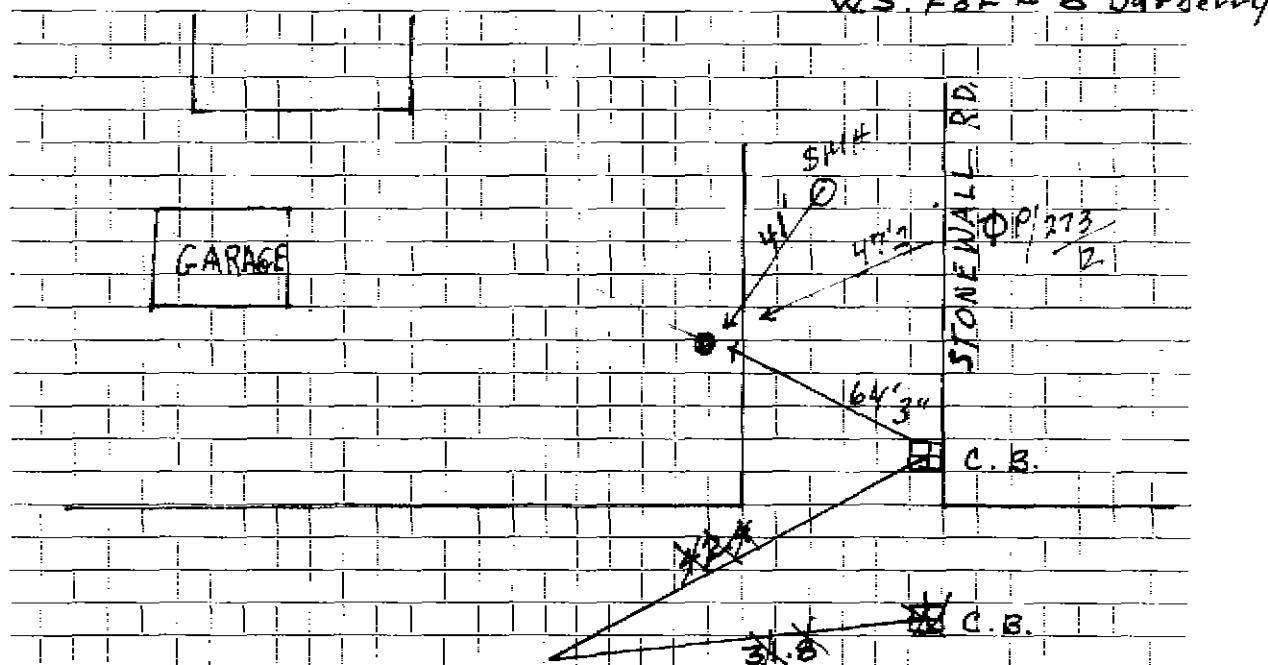

Connection made in Street. Work completed

Remarks: