

WATER SERVICE RECORD

Name VIVIAN BERMAN

Service No. 10

Address 9 Barberry Road

Location Lexington

~~Repair - Renewal~~ - New Service W. O. # 8536

JUN 5 1972


Date	Material	Amount	Total	Date	Amount
3/30/72	Labor	47 82		3-25-72	Deposit 175 00
4/12/72	"	15 58		6-5-72	Refund 36 32
	10% O.H.	6 34	69 74		NON CHARGE 148 68
18'	3/4" Copper pipe	.79	14 22	7/23/52	Labor 9 24
1	3/4" Corporation		9 57	10' - 3/4" Copper tubing @ .326	3 26
1	3/4" Curb Cock		11 32	1 - 3/4" C. Corp-cock	4 33
1/2	Ton Cold Patch	8.00	2 00	1 - 3/4" C x 3/4" C. Curb-cock	4 67
1 1/2	Ton Hot Top	7.45	11 08	1 Box and Rod	4 68
2 1/2	Hrs. Trucking	3.00	7 50	1 hr. trucking	75
1/2	Hr. Trucking	1.50	75		26 93
3	Hrs. Shovel	6.50	19 50		
1/2	Hr. Roller	2.00	1 00		
	Trailer		2 00		
			148 68		

DATE _____

TOWN OF LEXINGTON — BOARD OF PUBLIC WORKS

WATER DIVISION

Sketch of Service Here

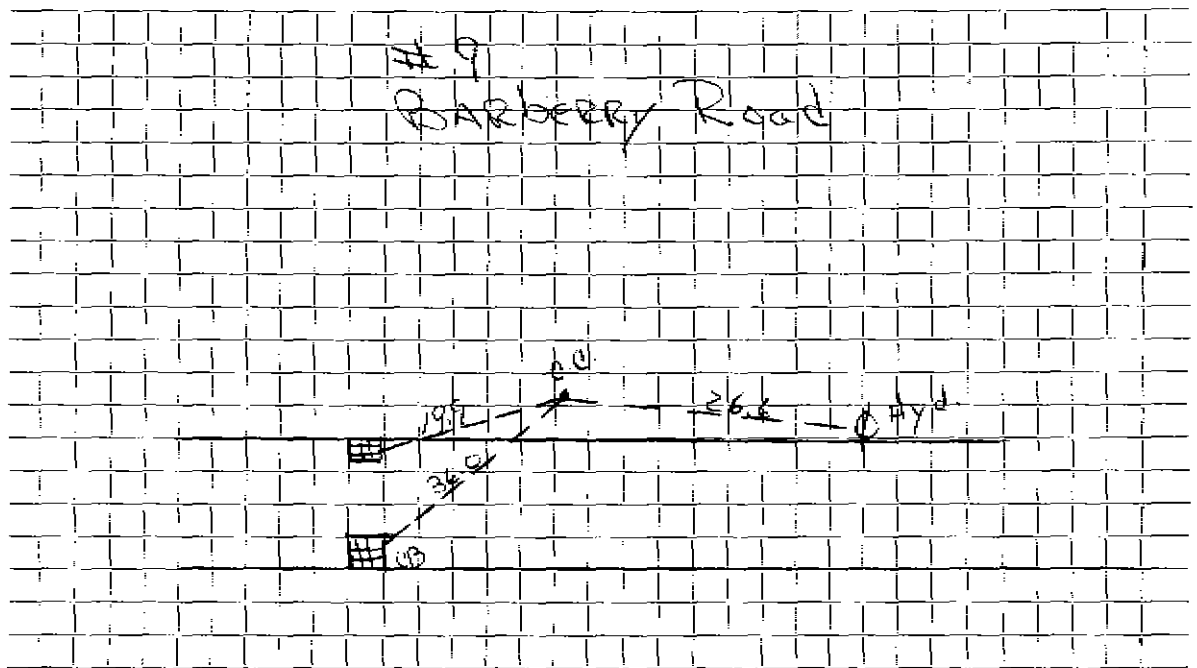

Connection made in Street. Work completed

Remarks:

.....

.....