

**WATER SERVICE RECORD**

Name \_\_\_\_\_

Service No. \_\_\_\_\_

Address \_\_\_\_\_

Location 21 Barnes Place

Repair—Renewal—New Service \_\_\_\_\_


Date	Material	Amount	Total	Date	Material	Amount	Total
9-22-86	22' 1" Iron						
					OUTSIDE		
				9-22-86	81' 3/4" Copper		
					2 1" STYLE 138		
					1 3/4" 3 pt. union		
					1 3/4" Corp.		
					1 3/4" Curb		
					1 1" Plug		
					2 1x6 Nipple		
					1 Box & Rod		
					48 yds. Gravel		

DATE \_\_\_\_\_

TOWN OF LEXINGTON — BOARD OF PUBLIC WORKS

**WATER DIVISION**

Sketch of Service Here

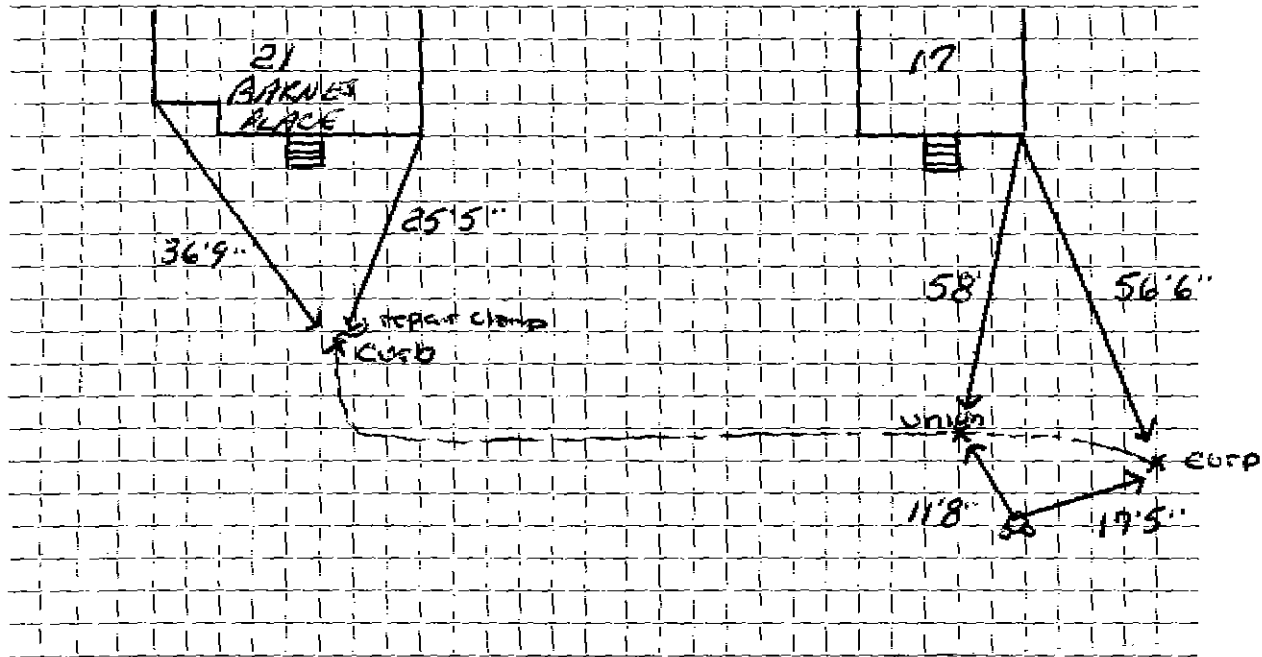

Connection made in ..... Street. Work completed .....

Remarks: .....

.....

.....